



City of Prince George History Sheet

PID:	030896193
SD/MU:	
WO:	

Civic Address: 9018 Inglewood Rd

Legal Description: Lot: 2 District Lot: 2422 Plan: EPP90556


Service Type	Diameter (mm)	Material	Invert Elev at main (m)	Invert Elev at property line (m)	Invert Elev at service end (m)	Distance into property (m)	Installation Date
Sanitary	N/A	N/A	-	-	-	-	-
Water	N/A	N/A	-	-	-	-	
Storm	N/A	N/A	-	-	-	-	

Service Connection Location						Sanitary (m)	Storm (m)
Distance from downstream San MH			-	towards upstream San MH	-	-	
Distance from downstream Stm MH			-	towards upstream Stm MH	-		

Power	Size	Communications	Size	Cable	Size	Gas	Size
BC Hydro	-	Telus	-	Shaw	-	FortisBC	-
Overhead Service		Overhead Service		Overhead Service			

Installed by:	Survey Date:	-
Comments:		

NOT TO SCALE The information contained herein is for internal use only.
Not to be relied on unless confirmed by site inspection and/or investigation.

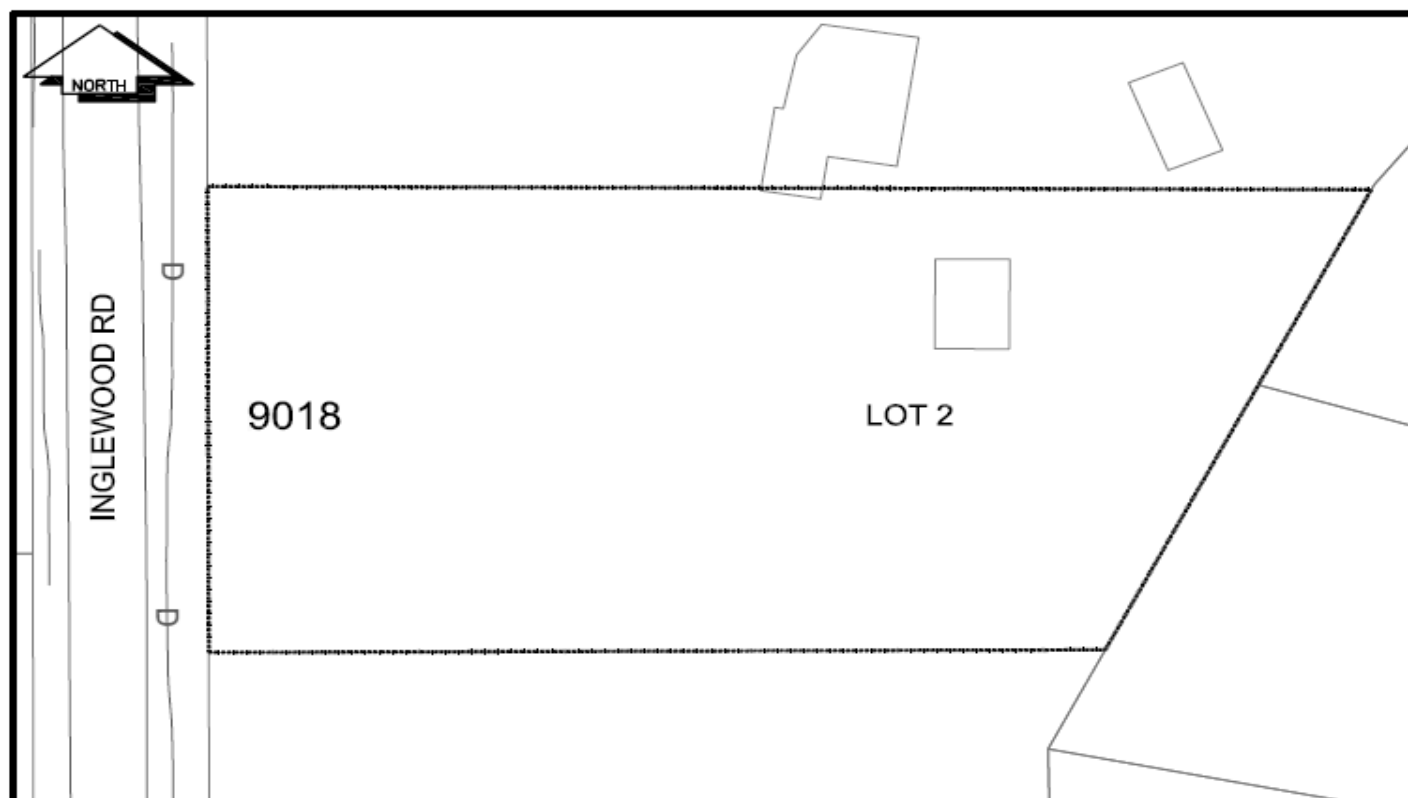

CS CURB STOP	— — — — — WATER SERVICE	— — — — — STORM SERVICE
CO CLEAN OUT	— — — — — SANITARY SERVICE	— G — GAS
⊗ WATER VALVE	⊗ FIRE HYDRANT	— — — — — ENCUMBERANCE

NOT TO SCALE