



City of Prince George History Sheet

PID:	030939861
SD/MU:	
WO:	

Civic Address: 3102, 3112 St Anne Cres

Legal Description: Lot: A District Lot: 1605 Cariboo District Plan: EPP44538


Service Type	Diameter (mm)	Material	Invert Elev at main (m)	Invert Elev at property line (m)	Invert Elev at service end (m)	Distance into property (m)	Installation Date
Sanitary (S1)	200mm	PVC	-	-	-	-	December 1993
Water (W1)	50mm	PVC	-	-	-	-	December 1994
Storm (D1)	250mm	PVC	-	-	-	-	December 1993
Sanitary (S2)	150mm	PVC	-	-	651.33	-	December 1993
Water (W2)	100mm	PVC	-	-	-	-	December 1994
Storm (D2)	300mm	PVC	-	-	651.75	-	December 1993

Service Connection Location	Sanitary (m)	Storm (m)
150mm Sanitary service connected to San MH4305	-	
300mm Storm service connected to Stm MH478		

Power	Size	Communications	Size	Cable	Size	Gas	Size
BC Hydro	-	Telus	-	Shaw	-	FortisBC	-
Underground Service		Underground Service		Underground Service			

Installed by:	Survey Date:	-
Comments:		

NOT TO SCALE The information contained herein is for internal use only.
Not to be relied on unless confirmed by site inspection and/or investigation.

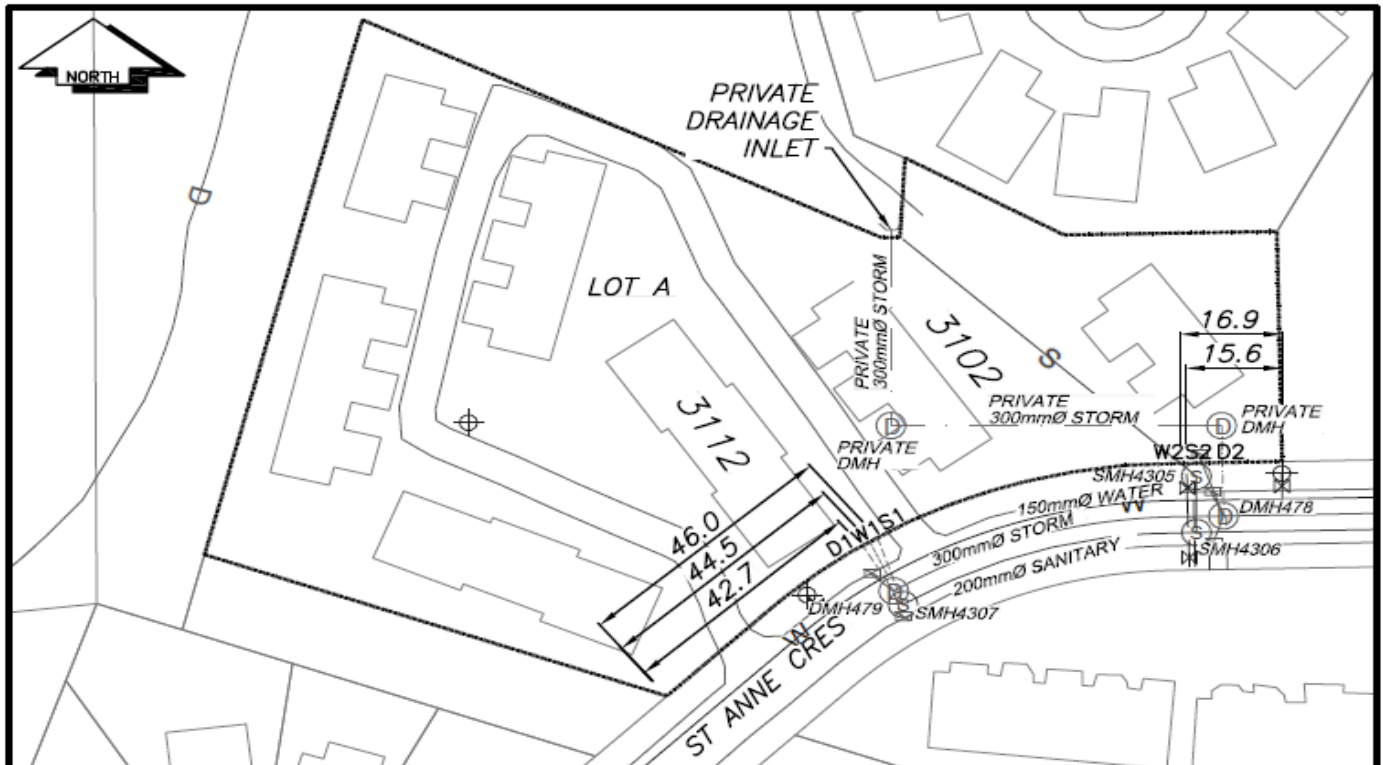

CS ^o CURB STOP	—X— WATER SERVICE	—o— STORM SERVICE
CO ^o CLEAN OUT	- - - - - SANITARY SERVICE	—G— GAS
⊗ WATER VALVE	—X— FIRE HYDRANT	- - - - - ENCUMBRANCE

NOT TO SCALE