

# City of Prince George

## HISTORY SHEET

PID:	030-959-691
SD/MU:	SD100549
WO:	

CIVIC ADDRESS: 4657 MARBLE STREET


LEGAL DESCRIPTION: LOT 3 DISTRICT LOT 4050 PLAN EPP89775

[illegible]**ELECTRICAL / COMMUNICATIONS / GAS**

TYPE	PROVIDER	SIZE AND MATERIAL	LOCATION ( UNDERGROUND/ OVERHEAD)
ELECTRICAL	BC HYDRO	75mm DB2	UNDERGROUND
COMMUNICATION	TELUS	50mm DB2	UNDERGROUND
COMMUNICATION	SHAW	50mm DB2	UNDERGROUND
GAS	FORTISBC	42 PROP/P.E.	UNDERGROUND

INFORMATION SHEETS: L&M ENGINEERING LIMITED PROJECT NUMBER 1596-02	SURVEY DATE: AUGUST 2018
INSTALLED BY: NAKIB CONSTRUCTION LTD.	
COMMENTS:	

THE INFORMATION CONTAINED HEREIN IS FOR INTERNAL USE ONLY.  
NOT TO BE RELIED UPON UNLESS CONFIRMED BY SITE INVESTIGATION.

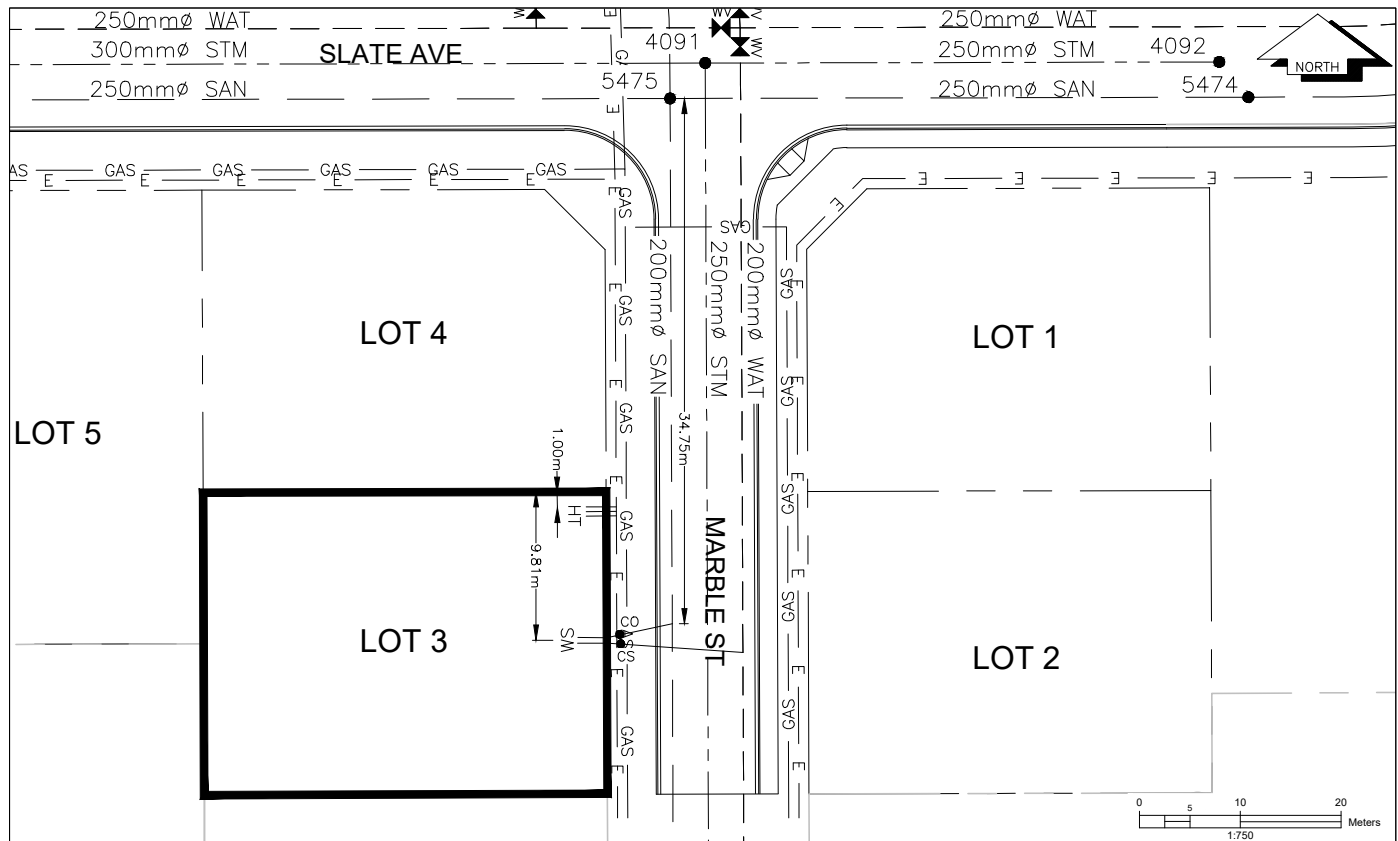

**LEGEND:**

CS	CURB STOP	_____	W	WATER SERVICE	_____	H	HYDRO SERVICE	_____	GAS	_____	GAS
CO	CLEAN OUT	_____	S	STORM SERVICE	_____	T	TELECOMMUNICATIONS	_____	E	_____	ELECTRICAL
		_____	S	SANITARY SERVICE							