



CITY OF
PRINCE GEORGE

City of Prince George HISTORY SHEET

PID:	030-959-764
SD/MU:	SD100549
WO:	

CIVIC ADDRESS: 4721 FOSSIL CRESCENT


LEGAL DESCRIPTION: LOT 10 DISTRICT LOT 4050 PLAN EPP89775

SERVICE TYPE	DIAMETER (mm)	MATERIAL	INVERT ELEV AT MAIN (m)	INVERT ELEV AT PROPERTY LINE (m)	INVERT ELEV AT SERVICE END (m)	COVER AT PROPERTY LINE (m)	DISTANCE INTO PROPERTY (m)	INSTALLATION DATE
SANITARY	100	PVC	601.62	602.09	602.15	2.91	3.00	AUGUST 2018
WATER	19	COPPER	601.98	602.00	602.06	3.07	3.00	AUGUST 2018
STORM	N/A	N/A	N/A	N/A	N/A	N/A	N/A	N/A

ELECTRICAL / COMMUNICATIONS / GAS			
TYPE	PROVIDER	SIZE AND MATERIAL	LOCATION (UNDERGROUND/ OVERHEAD)
ELECTRICAL	BC HYDRO	75mm DB2	UNDERGROUND
COMMUNICATION	TELUS	50mm DB2	UNDERGROUND
COMMUNICATION	SHAW	50mm DB2	UNDERGROUND
GAS	FORTISBC	42 PROP/P.E.	UNDERGROUND

INFORMATION SHEETS: L&M ENGINEERING LIMITED PROJECT NUMBER 1596-02	SURVEY DATE: AUGUST 2018
INSTALLED BY: NAKIB CONSTRUCTION LTD.	
COMMENTS:	

THE INFORMATION CONTAINED HEREIN IS FOR INTERNAL USE ONLY.
NOT TO BE RELIED UPON UNLESS CONFIRMED BY SITE INVESTIGATION.

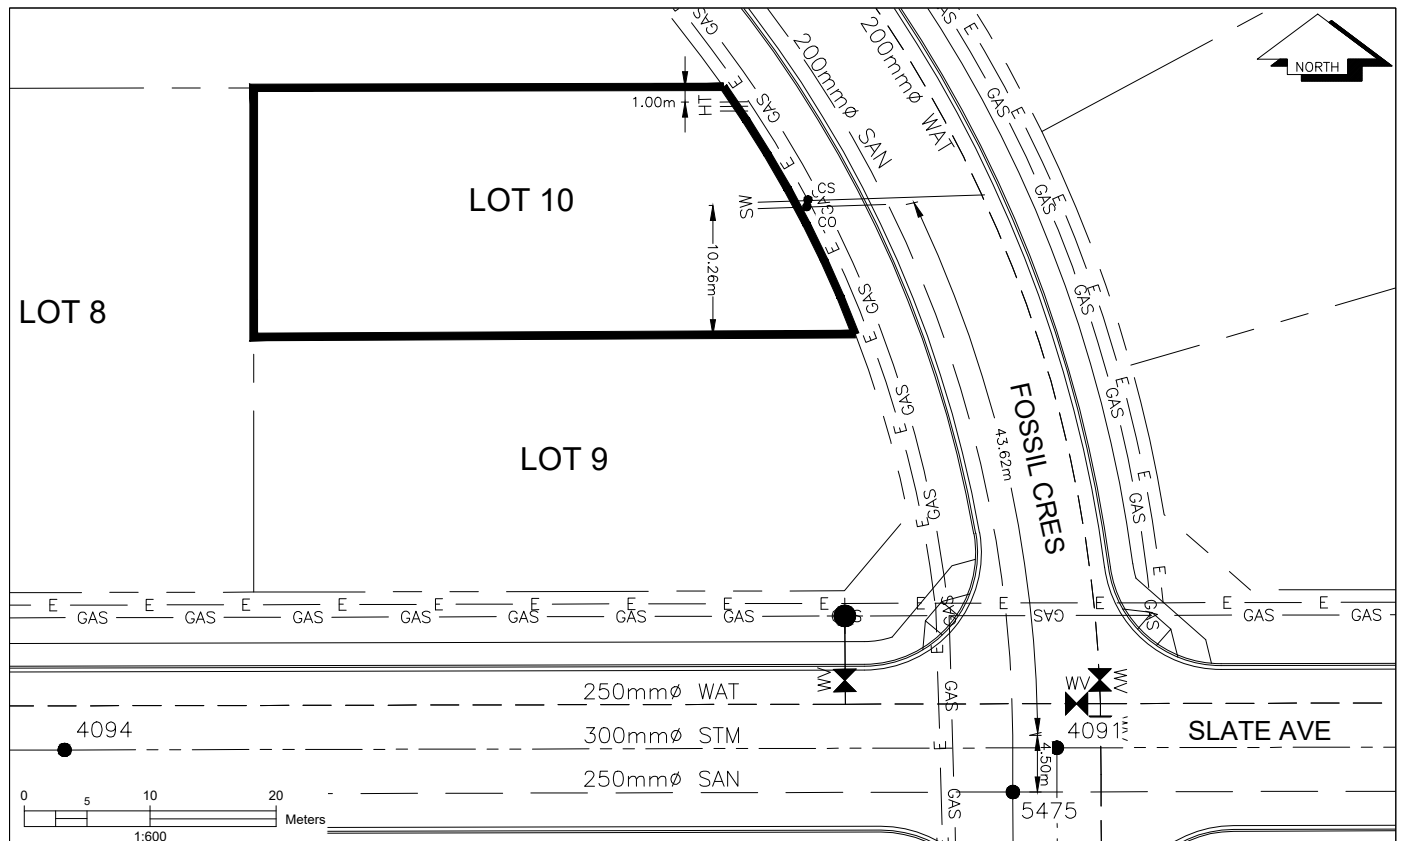

LEGEND:	CS. CURB STOP	W WATER SERVICE	HYDRO SERVICE	GAS GAS
	CO. CLEAN OUT	S.D.W. STORM SERVICE	TELECOMMUNICATIONS	E ELECTRICAL
		S SANITARY SERVICE		