



CITY OF  
PRINCE GEORGE

## City of Prince George HISTORY SHEET

|        |             |
|--------|-------------|
| PID:   | 030-959-802 |
| SD/MU: | SD100549    |
| WO:    |             |

CIVIC ADDRESS: 4718 FOSSIL CRESCENT


LEGAL DESCRIPTION: LOT 14 DISTRICT LOT 4050 PLAN EPP89775

| SERVICE TYPE | DIAMETER (mm) | MATERIAL | INVERT ELEV AT MAIN (m) | INVERT ELEV AT PROPERTY LINE (m) | INVERT ELEV AT SERVICE END (m) | COVER AT PROPERTY LINE (m) | DISTANCE INTO PROPERTY (m) | INSTALLATION DATE |
|--------------|---------------|----------|-------------------------|----------------------------------|--------------------------------|----------------------------|----------------------------|-------------------|
| SANITARY     | 100           | PVC      | 601.45                  | 602.46                           | 602.52                         | 2.45                       | 3.00                       | AUGUST 2018       |
| WATER        | 19            | COPPER   | 601.96                  | 602.45                           | 602.51                         | 2.53                       | 3.00                       | AUGUST 2018       |
| STORM        | N/A           | N/A      | N/A                     | N/A                              | N/A                            | N/A                        | N/A                        | N/A               |

| ELECTRICAL / COMMUNICATIONS / GAS |          |                   |                                   |
|-----------------------------------|----------|-------------------|-----------------------------------|
| TYPE                              | PROVIDER | SIZE AND MATERIAL | LOCATION ( UNDERGROUND/ OVERHEAD) |
| ELECTRICAL                        | BC HYDRO | 75mm DB2          | UNDERGROUND                       |
| COMMUNICATION                     | TELUS    | 50mm DB2          | UNDERGROUND                       |
| COMMUNICATION                     | SHAW     | 50mm DB2          | UNDERGROUND                       |
| GAS                               | FORTISBC | 42 PROP/P.E.      | UNDERGROUND                       |

|  |                          |
|--|--------------------------|
| INFORMATION SHEETS: L&M ENGINEERING LIMITED PROJECT NUMBER 1596-02 | SURVEY DATE: AUGUST 2018 |
| INSTALLED BY: NAKIB CONSTRUCTION LTD.                              |                          |
| COMMENTS:  |                          |

THE INFORMATION CONTAINED HEREIN IS FOR INTERNAL USE ONLY.  
NOT TO BE RELIED UPON UNLESS CONFIRMED BY SITE INVESTIGATION.

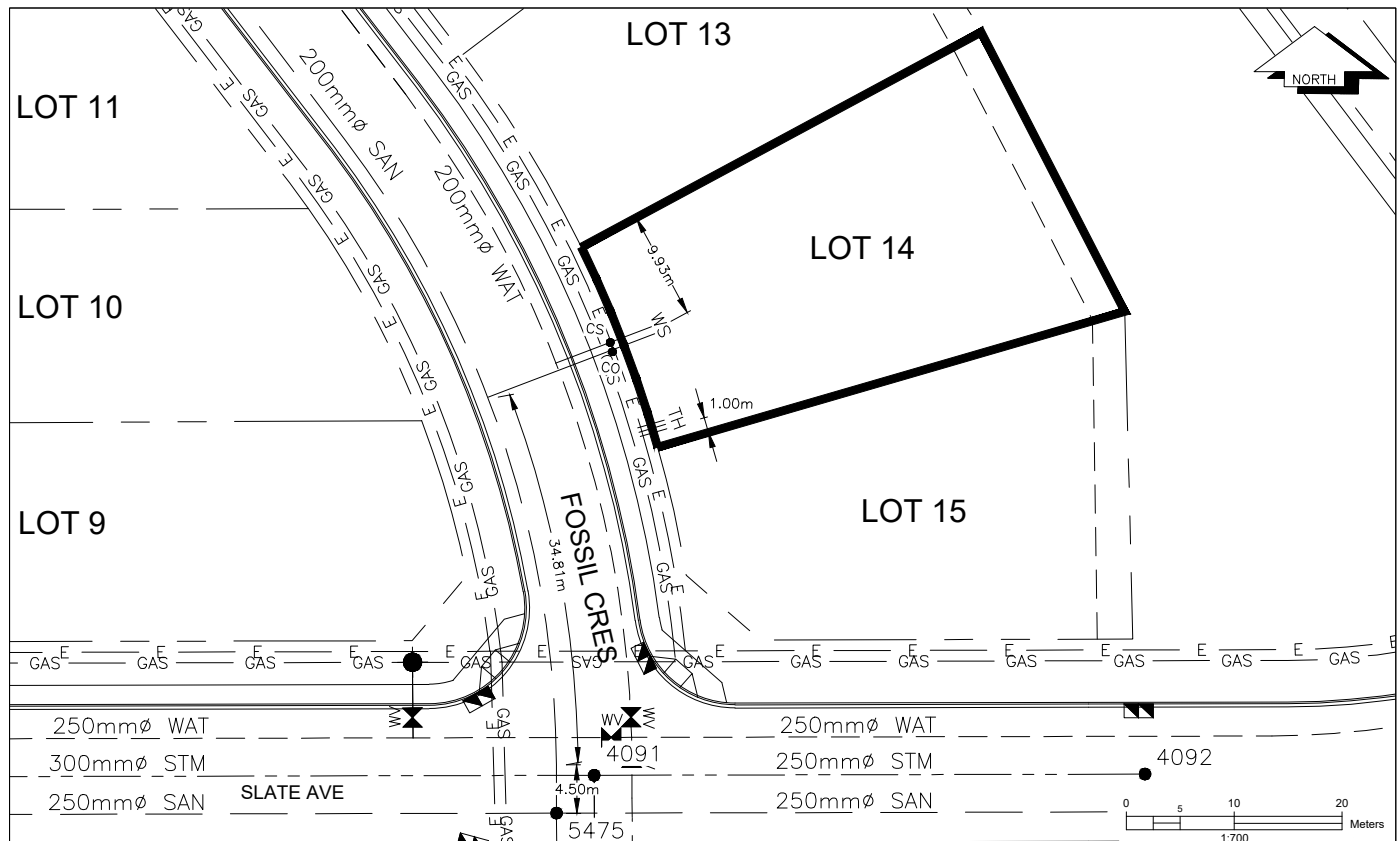

| LEGEND: |           |   |                    |
|---------|-----------|---|--------------------|
| CS      | CURB STOP | W | WATER SERVICE      |
| CO      | CLEAN OUT | D | STORM SERVICE      |
|         |           | S | SANITARY SERVICE   |
|         |           | H | HYDRO SERVICE      |
|         |           | T | TELECOMMUNICATIONS |
|         |           | G | GAS                |
|         |           | E | ELECTRICAL         |