



City of Prince George History Sheet

PID:	030981263
MU:	102101
WO:	99774/99783
	99775

Civic Address: 4624 Heather Rd

Legal Description: Lot: A District Lot: 4048 Plan: EPP93581


Service Type	Diameter (mm)	Material	Invert Elev at main (m)	Invert Elev at property line (m)	Invert Elev at service end (m)	Distance into property (m)	Installation Date
Sanitary	100mm	PVC	760.69	761.58	-	-	July 2019
Water	20mm	Copper	762.06	761.96	-	-	July 2019
Storm	100mm	PVC	762.43	762.86	-	-	July 2019

Service Connection Location				Sanitary (m)	Storm (m)
Distance from downstream San MH	262	towards upstream San MH	252	7.87	
Distance from downstream Stm MH	2914	towards upstream Stm MH	2945		5.62

Power	Size	Communications	Size	Cable	Size	Gas	Size
BC Hydro	-	Telus	-	Shaw	-	FortisBC	-
Overhead Service		Overhead Service		Overhead Service			

Installed by:	City of Prince George forces	Survey Date:	-
Comments:			

NOT TO SCALE The information contained herein is for internal use only.
Not to be relied on unless confirmed by site inspection and/or investigation.

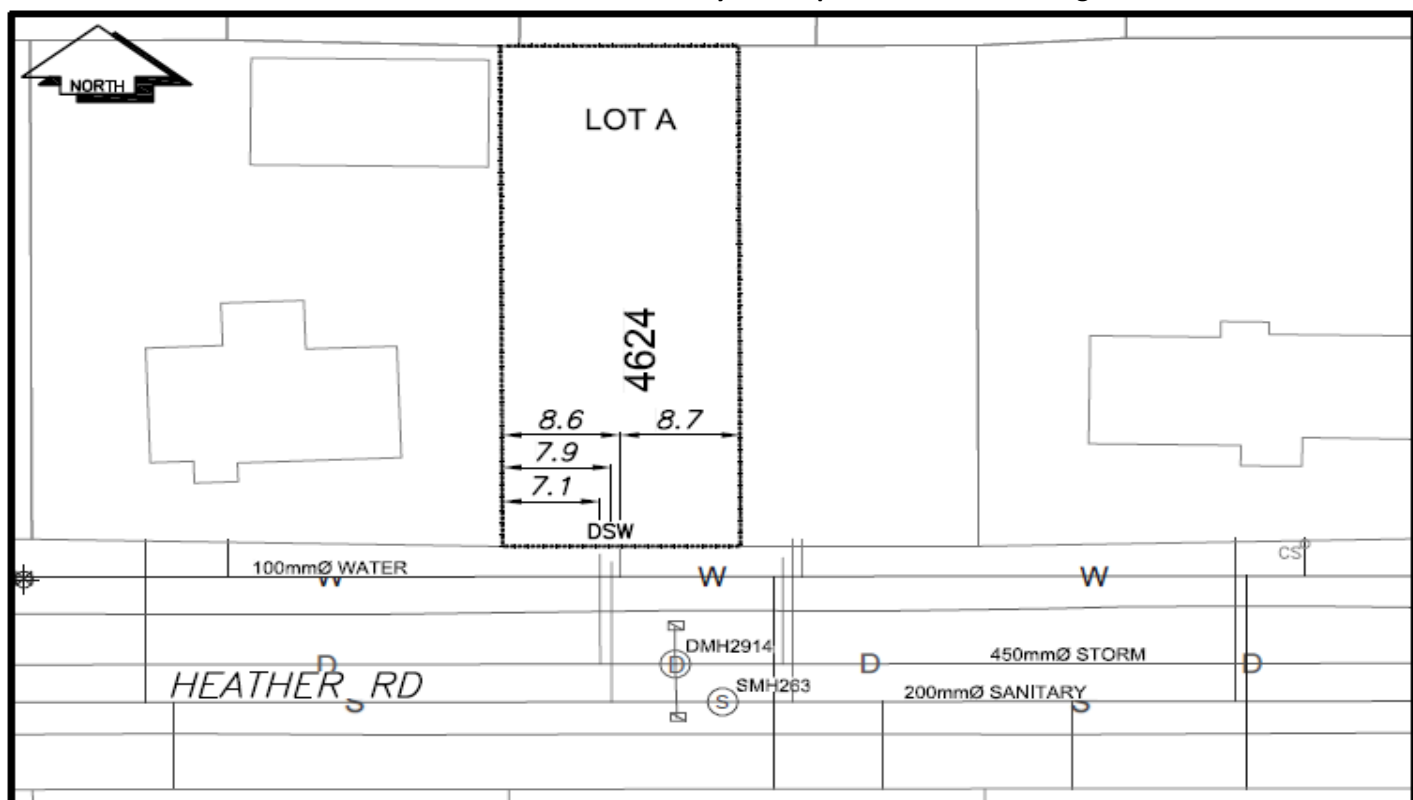

CS ^o CURB STOP	— — — — — WATER SERVICE	— — — — — STORM SERVICE
CO ^o CLEAN OUT	— — — — — SANITARY SERVICE	— — — — — GAS
⊗ WATER VALVE	⊗ FIRE HYDRANT	— — — — — ENCUMBRANCE

NOT TO SCALE