



# City of Prince George History Sheet

PID:	030981271
MU:	102101
WO:	99766/99777

Civic Address: 4608 Heather Rd

Legal Description: Lot: B District Lot: 4048 Plan: EPP93581


Service Type	Diameter (mm)	Material	Invert Elev at main (m)	Invert Elev at property line (m)	Invert Elev at service end (m)	Distance into property (m)	Installation Date
Sanitary	100mm	PVC	760.85	762.42	761.45	0.50	July 2019
Water	20mm	Copper	761.56	761.39	761.42	0.50	December 1971
Storm	100mm	PVC	761.09	762.27	-	-	July 2019

Service Connection Location				Sanitary (m)	Storm (m)
Distance from downstream San MH	262	towards upstream San MH	263	90.20	
Distance from downstream Stm MH	2912	towards upstream Stm MH	2914		90.10

Power	Size	Communications	Size	Cable	Size	Gas	Size
BC Hydro	-	Telus	-	Shaw	-	FortisBC	-
Overhead Service		Overhead Service		Overhead Service			

Installed by:	City of Prince George forces	Survey Date:	-
Comments:			

**NOT TO SCALE** The information contained herein is for internal use only.  
Not to be relied on unless confirmed by site inspection and/or investigation.

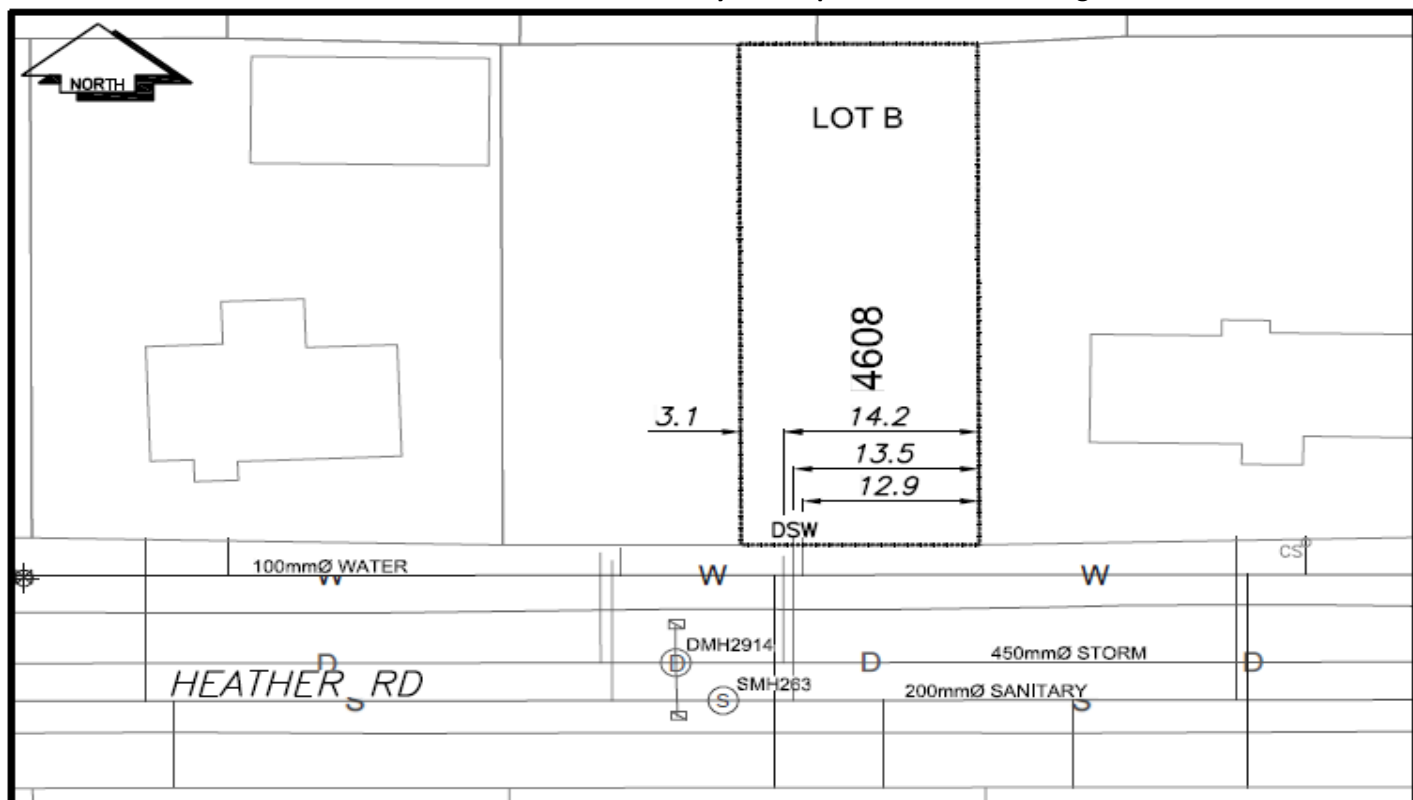

CS	CURB STOP	W	WATER SERVICE	S	STORM SERVICE
CO	CLEAN OUT	- - - -	SANITARY SERVICE	G	GAS
X	WATER VALVE	⊗	FIRE HYDRANT	- - - -	ENCUMBRANCE

**NOT TO SCALE**