



City of Prince George
History Sheet

PID:	030992214
MU:	102256
WO:	103692/103693

Civic Address: 930, 932 Douglas St

Legal Description: Lot: PCL C (CA7941617) Block: 6 District Lot: 1429 Plan: 646


Service Type	Diameter (mm)	Material	Invert Elev at main (m)	Invert Elev at property line (m)	Invert Depth at service end (m)	Distance into property (m)	Installation Date
Sanitary (S1)	100mm	AC	-	-	1.36	-	December 1959
Water (W1)	20mm	Copper	-	-	-	-	December 1959
Sanitary (S2)	100mm	PVC	587.30	587.04	587.07	-	August 2020
Water (W2)	20mm	Copper	587.72	587.62	587.79	-	August 2020
Storm	N/A	N/A	-	-	-	-	

Service Connection Location				Sanitary (m)	Storm (m)
Distance from downstream San MH	1974	towards upstream San MH	3062	51.51	
Distance from downstream San MH	1974	towards upstream San MH	3062	54.47	

Power	Size	Communications	Size	Cable	Size	Gas	Size
BC Hydro	-	Telus	-	Shaw	-	FortisBC	-
Overhead Service		Overhead Service		Overhead Service			

Installed by:	Water service (W2) and sanitary service (S2) installed by City of Prince George forces	Survey Date:	-
Comments:			

NOT TO SCALE The information contained herein is for internal use only.

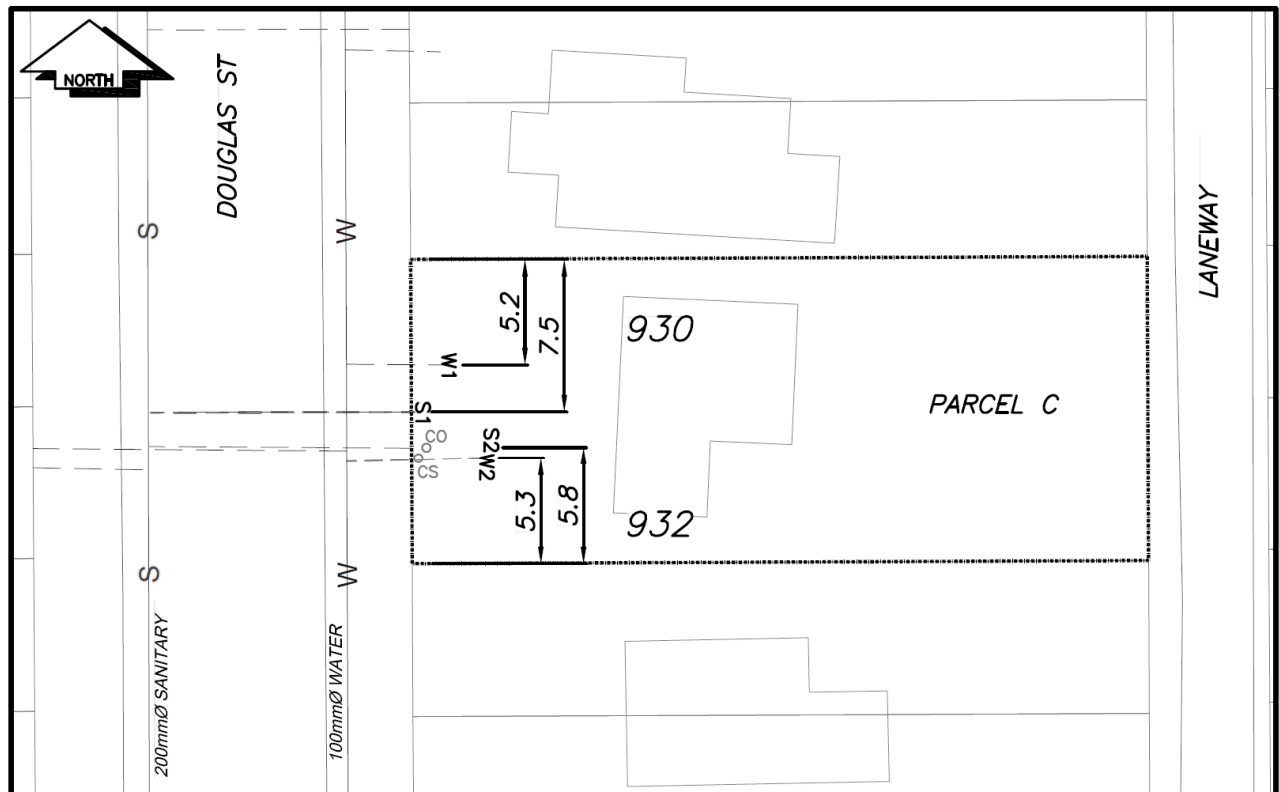

CS ^o	CURB STOP	—W—	WATER SERVICE	—S—	SANITARY SERVICE	—G—	GAS	—S—	STORM SERVICE
CO ^o	CLEAN OUT	---		---		---		---	
⊗	WATER VALVE	⊗	FIRE HYDRANT	---		---		---	ENCUMBRANCE

NOT TO SCALE