



City of Prince George  
**History Sheet**

PID:	031016146
MU:	102178
WO:	100941

Civic Address: 8189, 8191 Sabyam Rd

Legal Description: Lot: 1 District Lot: 2424 Plan: EPP95918


Service Type	Diameter (mm)	Material	Invert Elev at main (m)	Invert Elev at property line (m)	Invert Elev at service end (m)	Distance into property (m)	Installation Date
Sanitary	100mm	PVC	-	-	-	-	September 2019
Water	20mm	Copper	-	-	-	-	December 1971
Storm	N/A	N/A	-	-	-	-	

Service Connection Location	Sanitary (m)	Storm (m)
100mm Sanitary service connected to San MH111	-	
Distance from downstream Stm MH - towards upstream Stm MH -		

Power	Size	Communications	Size	Cable	Size	Gas	Size
BC Hydro	-	Telus	-	Shaw	-	FortisBC	-
Overhead Service		Overhead Service		Overhead Service			

Installed by:	Survey Date:	-
Comments:		

**NOT TO SCALE** The information contained herein is for internal use only.  
Not to be relied on unless confirmed by site inspection and/or investigation.

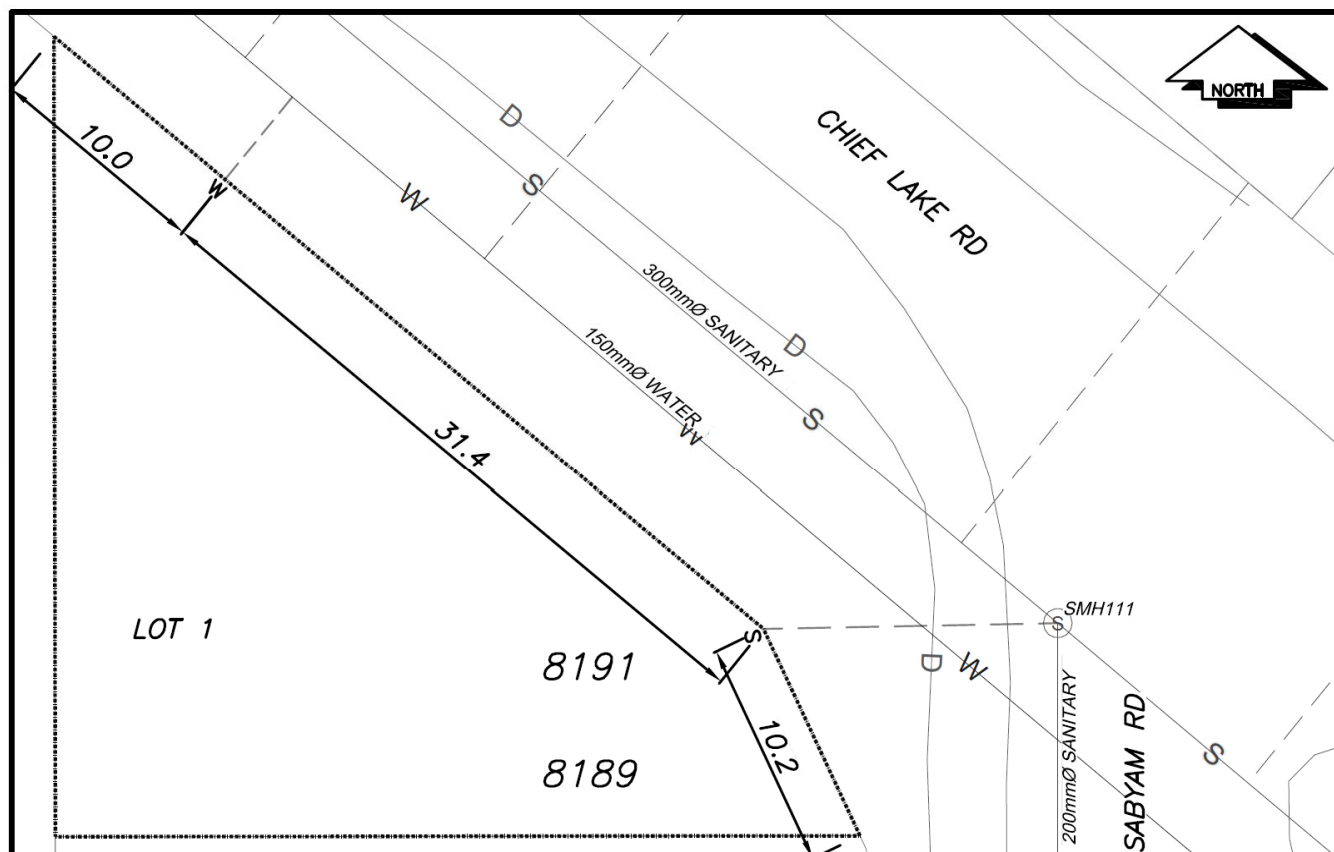

CS<sup>o</sup> CURB STOP  
CO<sup>o</sup> CLEAN OUT

— WATER SERVICE  
- - - - - SANITARY SERVICE

— STORM SERVICE  
—G— GAS

**NOT TO SCALE**

 
LEGEND:



WATER VALVE



FIRE HYDRANT



ENCUMBERANCE