



# City of Prince George History Sheet

PID:	031019013
MU:	
WO:	

Civic Address: 7589 Giscome Rd

Legal Description: Lot: A District Lot: 634 Plan: EPP94624


Service Type	Diameter (mm)	Material	Invert Elev at main (m)	Invert Elev at property line (m)	Invert Elev at service end (m)	Distance into property (m)	Installation Date
Sanitary	100mm	PVC	-	-	-	-	September 1991
Water	20mm	Copper	-	-	-	-	September 1991
Storm	N/A	N/A	-	-	-	-	

Service Connection Location				Sanitary (m)	Storm (m)
Distance from downstream San MH	1160	towards upstream San MH	1167	-	
Distance from downstream Stm MH	-	towards upstream Stm MH	-		

Power	Size	Communications	Size	Cable	Size	Gas	Size
BC Hydro	-	Telus	-	Shaw	-	FortisBC	-
Overhead Service		Overhead Service		Overhead Service			

Installed by:	Survey Date:	-
Comments:		

**NOT TO SCALE** The information contained herein is for internal use only.  
Not to be relied on unless confirmed by site inspection and/or investigation.

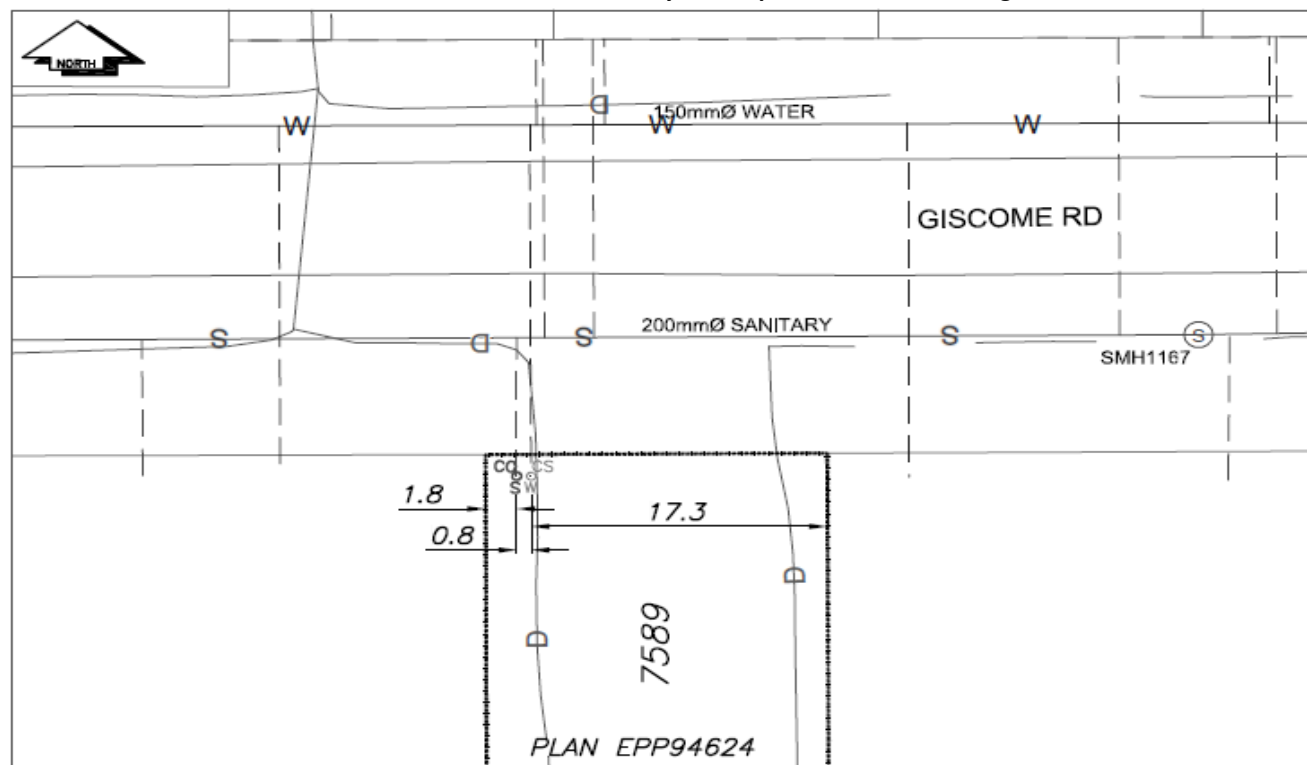

LEGEND:	CS CURB STOP	— WATER SERVICE	— STORM SERVICE
LEGEND:	66 CLEAN OUT	== SANITARY SERVICE	—G— WATER VALVE
LEGEND:	— WATER VALVE	— FIRE HYDRANT	— ENCUMBRANCE

**NOT TO SCALE**