



City of Prince George
History Sheet

PID:	031038549
SD/MU:	
WO:	

Civic Address: 2860 Gogolin Rd

Legal Description: Lot: A District Lot: 1433 Plan: EPP87153


Service Type	Diameter (mm)	Material	Invert Elev at main (m)	Invert Elev at property line (m)	Invert Depth at service end (m)	Distance into property (m)	Installation Date
Sanitary	100mm	Vit	-	-	2.74	-	December 1975
Water	20mm	Copper	-	-	-	-	December 1966
Storm	N/A	N/A	-	-	-	-	

Service Connection Location	Sanitary (m)	Storm (m)
100mm Sanitary connected to San MH3567	-	
Distance from downstream Stm MH - towards upstream Stm MH -		

Power	Size	Communications	Size	Cable	Size	Gas	Size
BC Hydro	-	Telus	-	Shaw	-	FortisBC	-
Overhead Service		Overhead Service		Overhead Service			

Installed by:	Survey Date:	-
Comments:		

NOT TO SCALE The information contained herein is for internal use only.
Not to be relied on unless confirmed by site inspection and/or investigation.

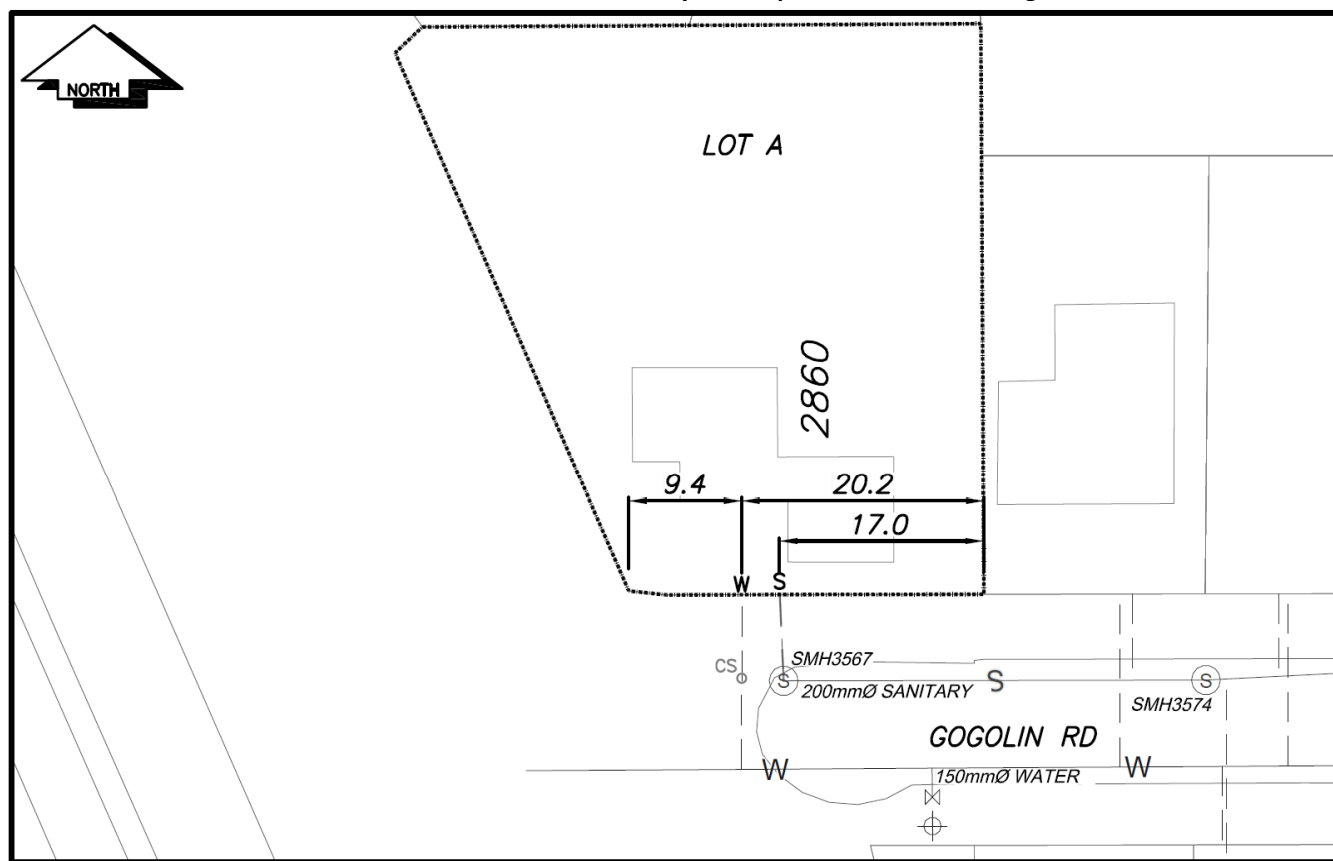

CS CURB STOP
CO CLEAN OUT

WATER SERVICE
SANITARY SERVICE

STORM SERVICE
GAS

NOT TO SCALE


LEGEND:



WATER VALVE



FIRE HYDRANT

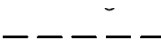

ENCUMBERANCE