



# City of Prince George History Sheet

PID:	031062296
SD/MU:	
WO:	

Civic Address: 2830, 2840 Vance Pl

Legal Description: Lot: A District Lot: 1433 Plan: EPP93623


Service Type	Diameter (mm)	Material	Invert Elev at main (m)	Invert Elev at property line (m)	Invert Elev at service end (m)	Distance into property (m)	Installation Date
Sanitary (S1)	100mm	AC	-	-	-	-	December 1977
Water (W1)	20mm	Copper	-	-	-	-	December 1966
Storm (D1)	100mm	AC	-	-	-	-	December 1977
Sanitary (S2)	100mm	AC	-	-	-	-	December 1977
Water (W2)	20mm	Copper	-	-	-	-	December 1966
Storm (D2)	100mm	AC	-	-	-	-	December 1977

Service Connection Location			Sanitary (m)	Storm (m)
Distance from downstream San MH	-	towards upstream San MH	-	
Distance from downstream Stm MH	-	towards upstream Stm MH	-	

Power	Size	Communications	Size	Cable	Size	Gas	Size
BC Hydro	-	Telus	-	Shaw	-	FortisBC	-
Underground Service		Underground Service		Underground Service			

Installed by:	Survey Date:	-
Comments:		

**NOT TO SCALE** The information contained herein is for internal use only.  
Not to be relied on unless confirmed by site inspection and/or investigation.

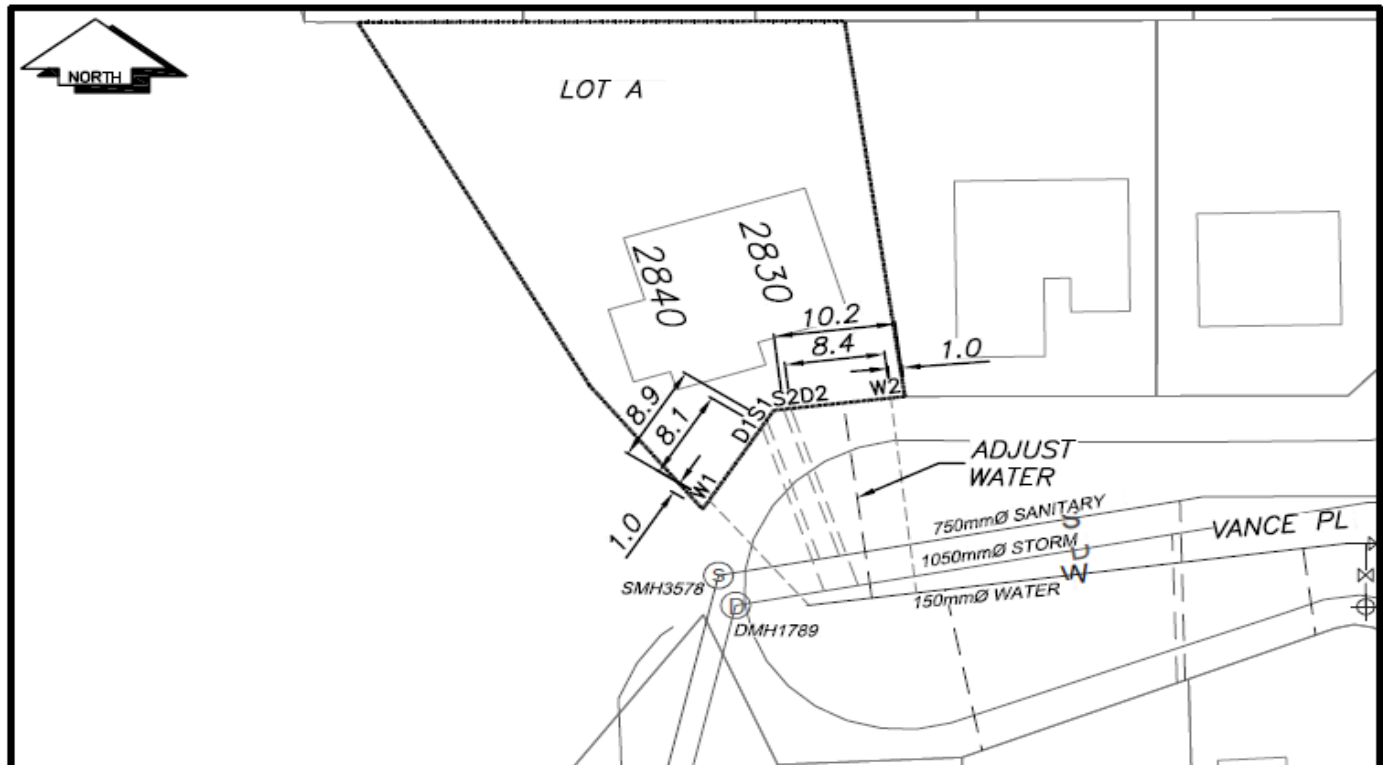

CS <sup>o</sup> CURB STOP	— — — — — WATER SERVICE	— — — — — STORM SERVICE
CO <sup>o</sup> CLEAN OUT	— — — — — SANITARY SERVICE	— — — — — GAS
⊗ WATER VALVE	⊗ FIRE HYDRANT	— — — — — ENCUMBRANCE

**NOT TO SCALE**