



# City of Prince George History Sheet

PID:	031064523
SD/MU:	
WO:	

Civic Address: 3020 Recplace Dr

Legal Description: Lot: 1 District Lot: 8180 Plan: EPP95708


Service Type	Diameter (mm)	Material	Invert Elev at main (m)	Invert Elev at property line (m)	Invert Elev at service end (m)	Distance into property (m)	Installation Date
Sanitary	N/A	N/A	-	-	-	-	-
Water	200mm	DI	-	-	586.09	3.00	June 2007
Storm	N/A	N/A	-	-	-	-	

Service Connection Location					Sanitary (m)	Storm (m)
Distance from downstream San MH	-	towards upstream San MH	-	-	-	
Distance from downstream Stm MH	-	towards upstream Stm MH	-	-		

Power	Size	Communications	Size	Cable	Size	Gas	Size
BC Hydro	-	Telus	-	Shaw	-	FortisBC	-
Underground Service		Underground Service		Underground Service			

Installed by:	Survey Date:	-
Comments:		

**NOT TO SCALE** The information contained herein is for internal use only.  
Not to be relied on unless confirmed by site inspection and/or investigation.

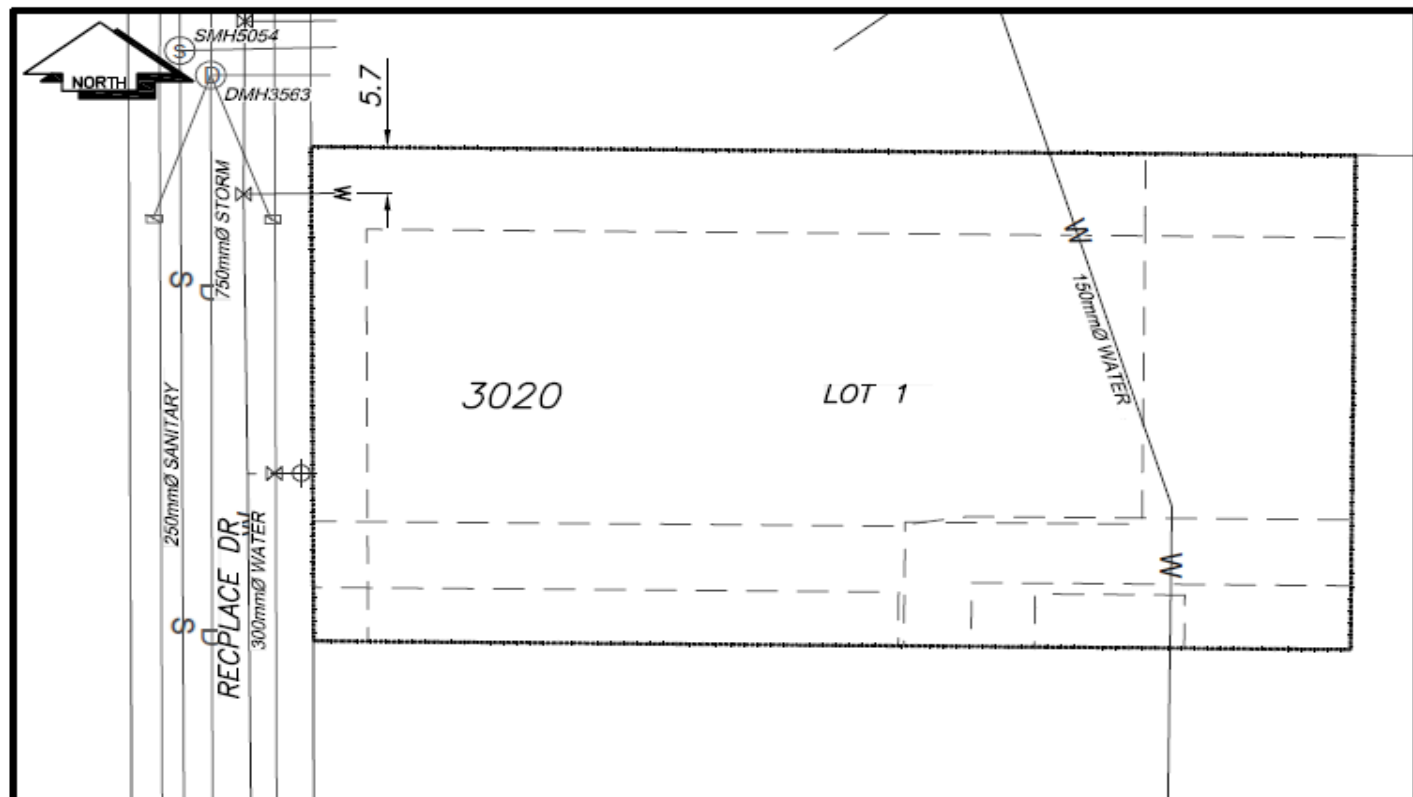

CS	CURB STOP	—	WATER SERVICE	—	STORM SERVICE
CO	CLEAN OUT	- - - -	SANITARY SERVICE	—G—	GAS
—X—	WATER VALVE	—X—	FIRE HYDRANT	- - - -	ENCUMBRANCE

**NOT TO SCALE**