



# City of Prince George History Sheet

PID:	031077986
SD/MU:	
WO:	

Civic Address: 1584 8th Ave

Legal Description: Lot: PCL D (CA8145152) Block: 181 District Lot: 343 Plan: 1268


Service Type	Diameter (mm)	Material	Invert Elev at main (m)	Invert Elev at property line (m)	Invert Elev at service end (m)	Distance into property (m)	Installation Date
Sanitary	Unknown	Unknown	-	-	-	-	-
Water	20mm	Copper	-	-	-	-	December 1958
Storm	N/A	N/A	-	-	-	-	

Service Connection Location						Sanitary (m)	Storm (m)
Distance from downstream San MH			towards upstream San MH			-	
Distance from downstream Stm MH			towards upstream Stm MH				

Power	Size	Communications	Size	Cable	Size	Gas	Size
BC Hydro	-	Telus	-	Shaw	-	FortisBC	-
Overhead Service		Overhead Service		Overhead Service			

Installed by:		Survey Date:	-
Comments:	Sanitary service location unknown.		

**NOT TO SCALE** The information contained herein is for internal use only.  
Not to be relied on unless confirmed by site inspection and/or investigation.

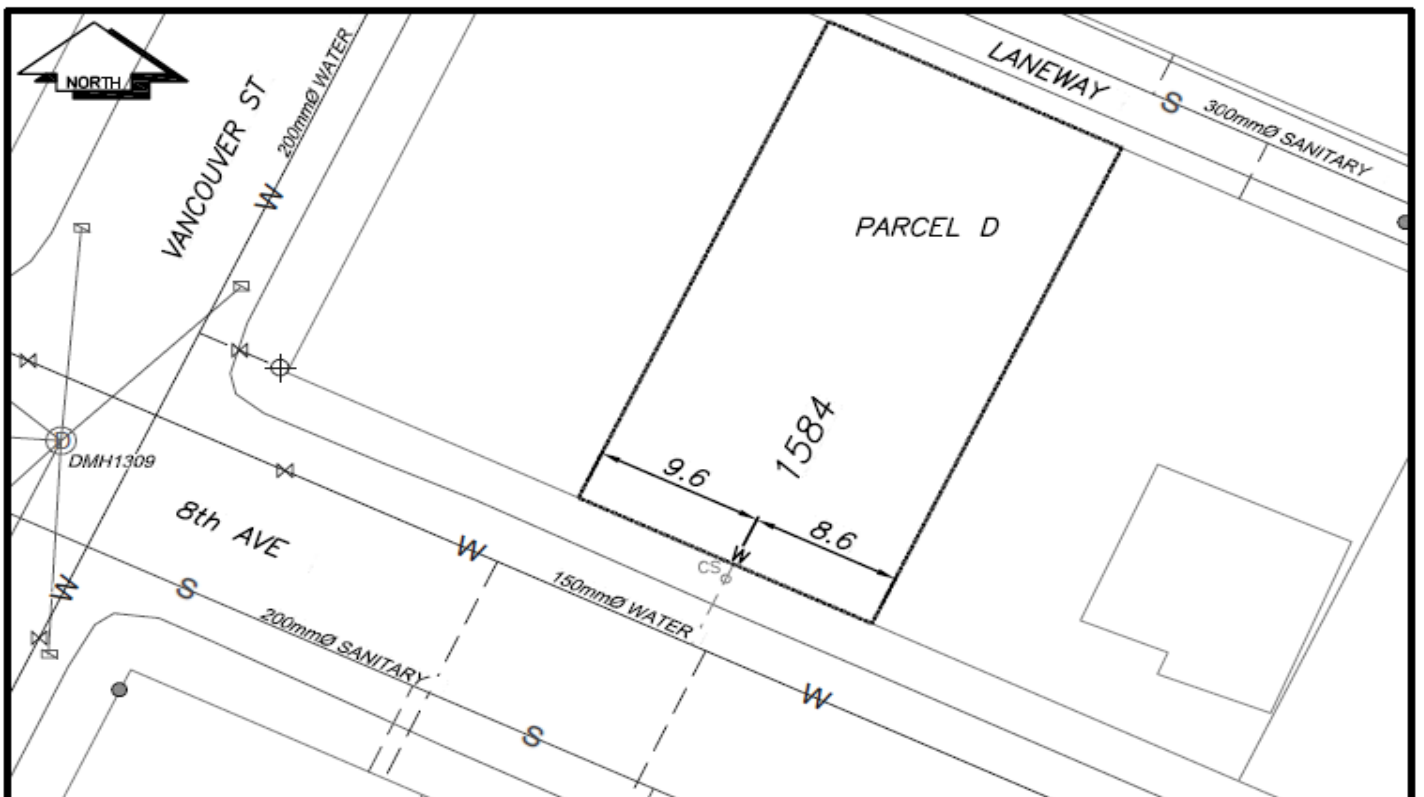

CS <sup>o</sup> CURB STOP	—W— WATER SERVICE	—S— STORM SERVICE
CO <sup>o</sup> CLEAN OUT	- - - - - SANITARY SERVICE	—G— GAS
⊗ WATER VALVE	⊗ FIRE HYDRANT	- - - - - ENCUMBRANCE

**NOT TO SCALE**