



CITY OF
PRINCE GEORGE

City of Prince George HISTORY SHEET

PID:	031-080-910
SD/MU:	SD100581
WO:	

CIVIC ADDRESS: 8976 TATLOW PLACE


LEGAL DESCRIPTION: LOT 2 DISTRICT LOT 2425 PLAN EPP98524

SERVICE TYPE	DIAMETER (mm)	MATERIAL	INVERT ELEV AT MAIN (m)	INVERT ELEV AT PROPERTY LINE (m)	INVERT ELEV AT SERVICE END (m)	COVER AT PROPERTY LINE (m)	DISTANCE INTO PROPERTY (m)	INSTALLATION DATE
SANITARY	100	PVC	763.99	764.39	764.44	2.18	3.00	JULY 2019
WATER	19	COPPER	763.88	764.14	764.17	2.43	3.00	JULY 2019
STORM	100	PVC	764.07	764.47	764.52	2.10	3.00	JULY 2019

ELECTRICAL / COMMUNICATIONS / GAS			
TYPE	PROVIDER	SIZE AND MATERIAL	LOCATION (UNDERGROUND/ OVERHEAD)
ELECTRICAL	BC HYDRO	75mm DB2	UNDERGROUND
COMMUNICATION	TELUS	50mm DB2	UNDERGROUND
COMMUNICATION	SHAW	50mm DB2	UNDERGROUND
GAS	FORTISBC	42 PROP/P.E.	UNDERGROUND

INFORMATION SHEETS: L&M ENGINEERING LIMITED PROJECT NUMBER 1631-02	SURVEY DATE: JULY 2019
INSTALLED BY: COREHAVEN HOMES	
COMMENTS:	

THE INFORMATION CONTAINED HEREIN IS FOR INTERNAL USE ONLY.
NOT TO BE RELIED UPON UNLESS CONFIRMED BY SITE INVESTIGATION.

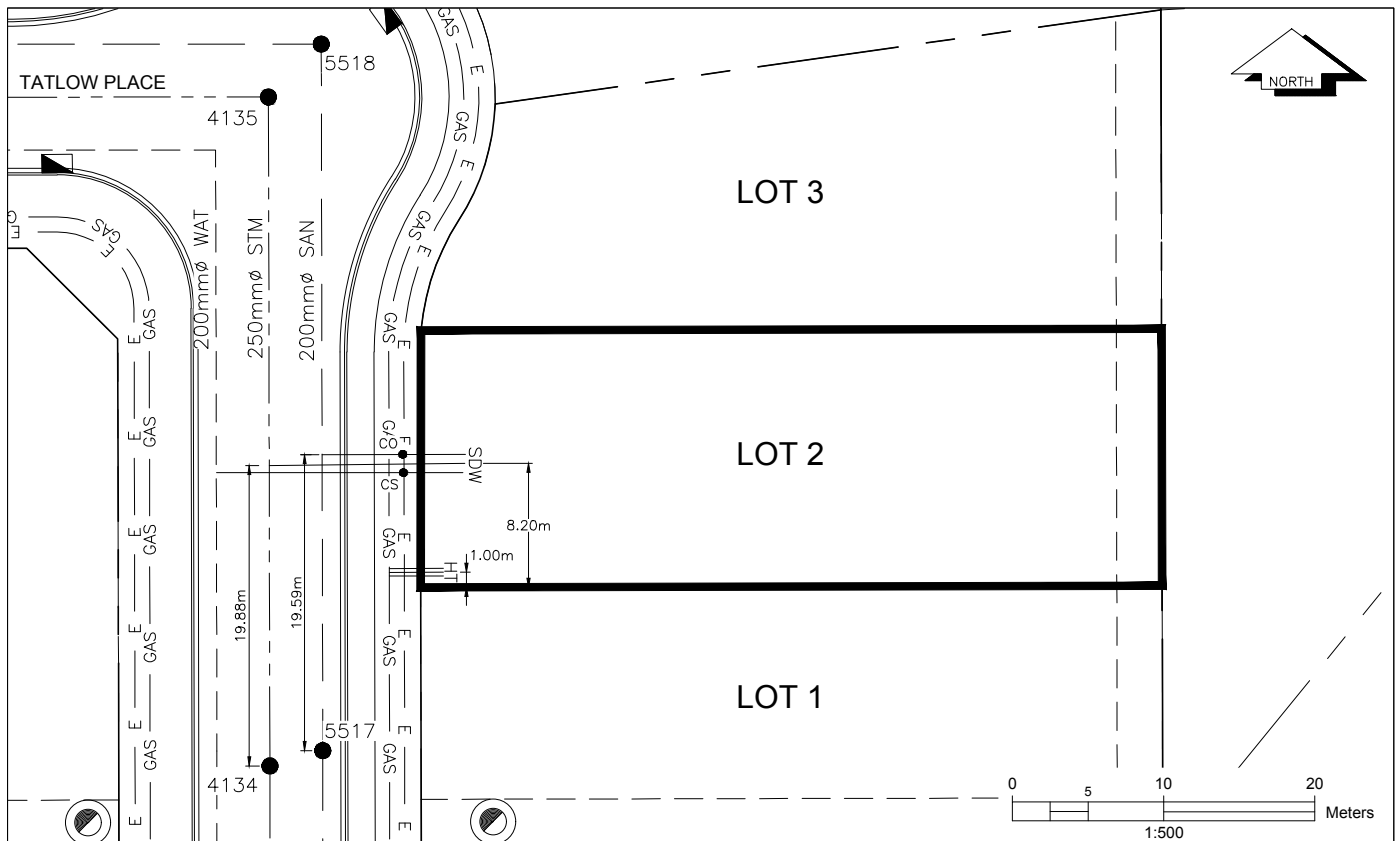

LEGEND:									
CS	CURB STOP	— W	WATER SERVICE	— H	HYDRO SERVICE	— GAS	GAS		
CO	CLEAN OUT	— S	STORM SERVICE	— T	TELECOMMUNICATIONS	— E	ELECTRICAL		
		— S	SANITARY SERVICE			—	LAWN BASIN		