



City of Prince George History Sheet

PID:	031101691
SD/MU:	
WO:	

Civic Address: 4721, 4759 Continental Way

Legal Description: Lot: 1 District Lot: 745 Plan: EPP95510


Service Type	Diameter (mm)	Material	Invert Elev at main (m)	Invert Elev at property line (m)	Invert Depth at service end (m)	Distance into property (m)	Installation Date
Sanitary	100mm	PVC	-	595.27	1.77	-	December 1981
Water	25mm	Copper	-	-	-	-	December 1982
Storm	150mm	PVC	-	595.53	1.53	-	December 1981

Service Connection Location				Sanitary (m)	Storm (m)
Distance from downstream San MH	3684	towards upstream San MH	3682	93.30	
Distance from downstream Stm MH	1907	towards upstream Stm MH	1908		93.00

Power	Size	Communications	Size	Cable	Size	Gas	Size
BC Hydro	-	Telus	-	Shaw	-	FortisBC	-
Overhead Service		Overhead Service		Overhead Service			

Installed by:	Survey Date:	-
Comments:		

NOT TO SCALE The information contained herein is for internal use only.
Not to be relied on unless confirmed by site inspection and/or investigation.

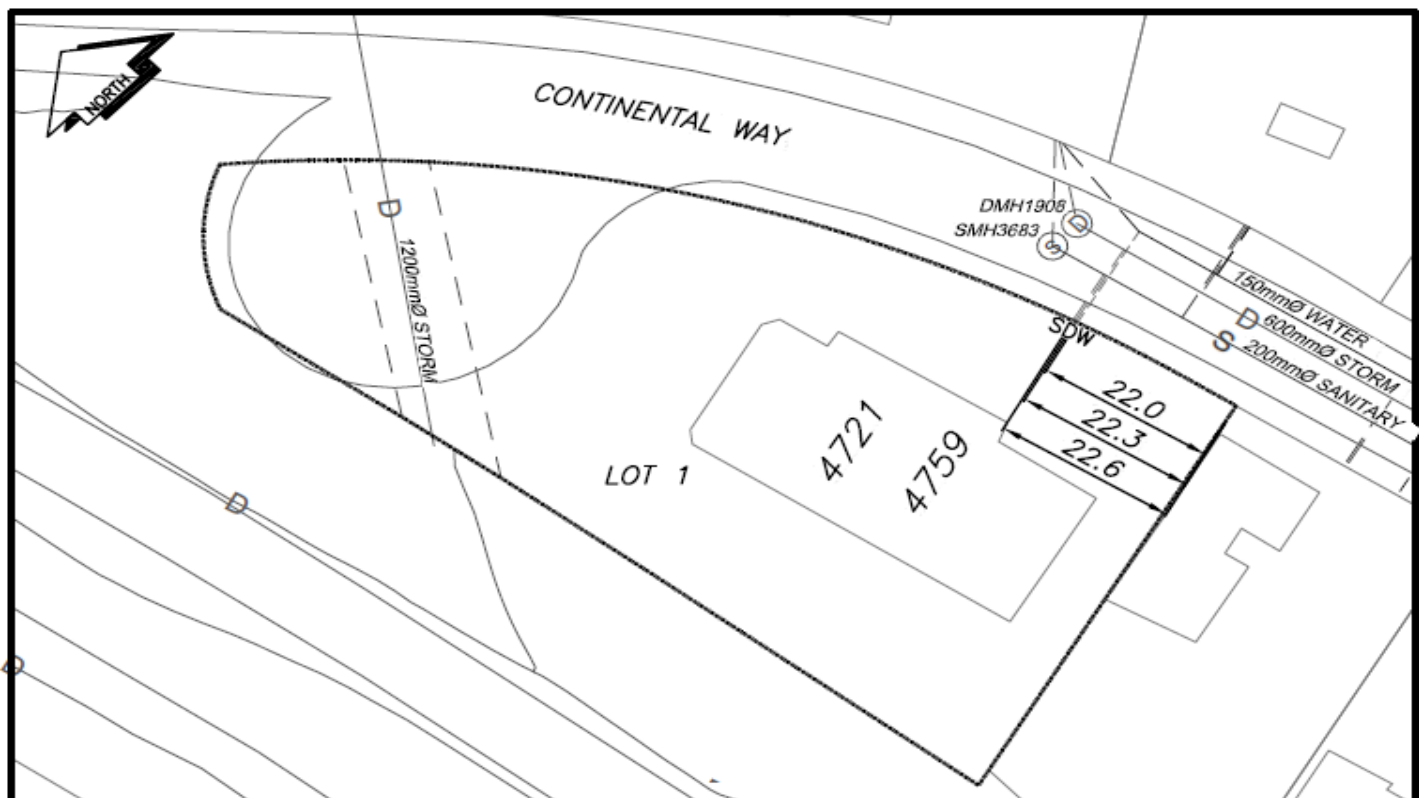

CS CURB STOP	— WATER SERVICE	— STORM SERVICE
CO CLEAN OUT	- - - - - SANITARY SERVICE	— G — GAS
⊗ WATER VALVE	⊗ FIRE HYDRANT	- - - - - ENCUMBRANCE

NOT TO SCALE