



# City of Prince George History Sheet

PID:	031109659
SD/MU:	
WO:	

Civic Address: 2224 Queensway

Legal Description: Lot: 1 District Lot: 417 Plan: EPP96798


Service Type	Diameter (mm)	Material	Invert Elev at main (m)	Invert Depth at property line (m)	Invert Elev at service end (m)	Distance into property (m)	Installation Date
Sanitary	100mm	AC	-	1.82	-	-	December 1980
Water (W1)	20mm	Copper	-	-	-	-	December 1980
Water (W2)	40mm	Copper	-	-	-	-	December 1954
Storm	200mm	CMP	-	-	-	-	December 1977

Service Connection Location				Sanitary (m)	Storm (m)
Distance from downstream San MH	3475	towards upstream San MH	1722	31.11	
Storm service connect to Stm MH3252					

Power	Size	Communications	Size	Cable	Size	Gas	Size
BC Hydro	-	Telus	-	Shaw	-	FortisBC	-
Overhead Service		Overhead Service		Overhead Service			

Installed by:	Survey Date:	-
Comments:		

**NOT TO SCALE** The information contained herein is for internal use only.  
Not to be relied on unless confirmed by site inspection and/or investigation.

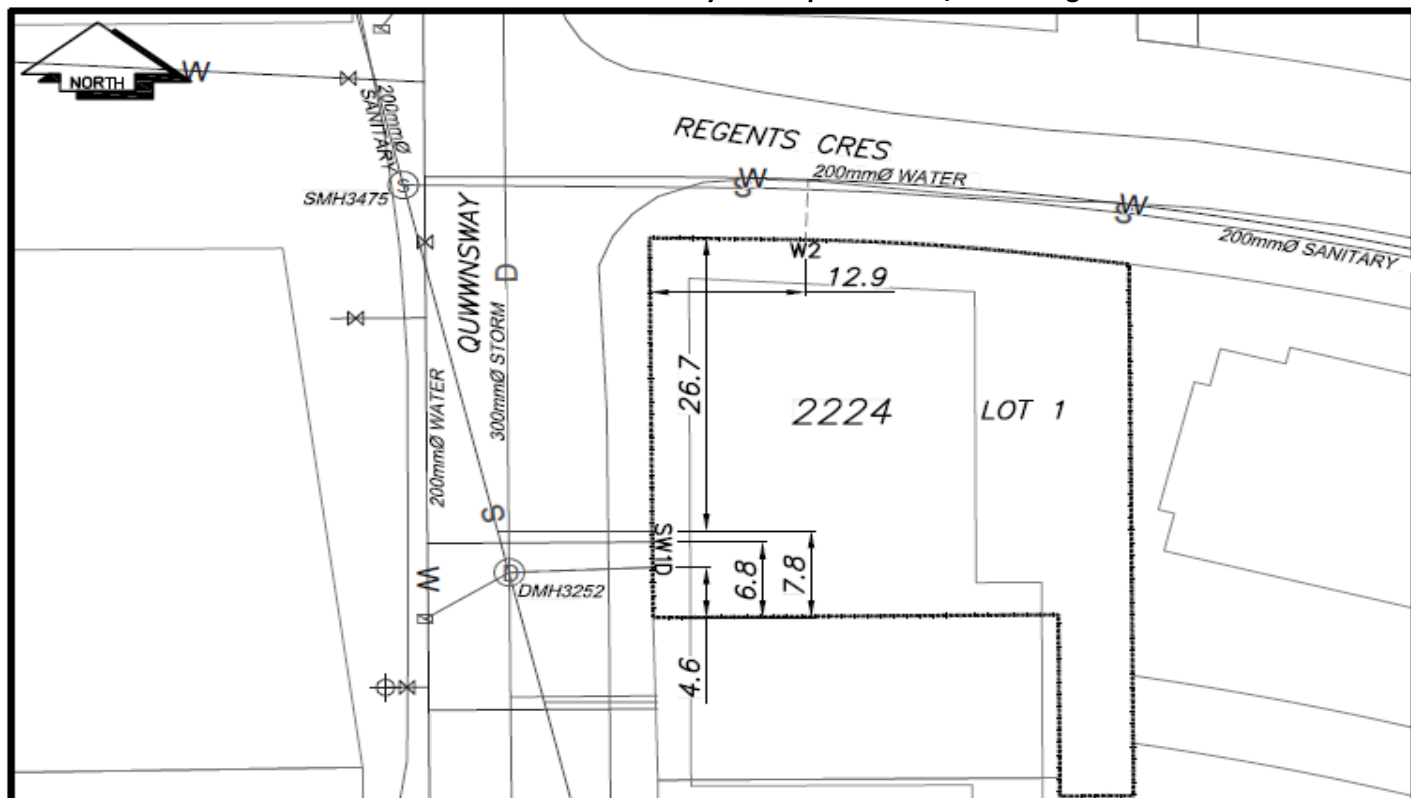

CS <sup>o</sup> CURB STOP	— W — WATER SERVICE	— S — STORM SERVICE
CO <sup>o</sup> CLEAN OUT	— S — SANITARY SERVICE	— G — GAS
⊗ WATER VALVE	⊗ FIRE HYDRANT	— — — ENCUMBRANCE

**NOT TO SCALE**