



City of Prince George History Sheet

PID:	031162576
SD:	100494
WO:	

Civic Address: 2424 Rowe St

Legal Description: Lot: PCL A (CA8348035) District Lot: 2616 Plan: EPP72860


Service Type	Diameter (mm)	Material	Invert Elev at main (m)	Invert Elev at property line (m)	Invert Depth at service end (m)	Distance into property (m)	Installation Date
Sanitary (S1)	100mm	PVC	730.52	731.05	2.37	3.00	May 2017
Water (W1)	20mm	Copper	730.00	730.92	2.49	3.00	May 2017
Storm (D1)	100mm	PVC	730.70	731.03	2.39	3.00	May 2017
Sanitary (S2)	100mm	PVC	-	730.24	730.84	3.00	May 2017
Water (W2)	20mm	Copper	-	729.85	730.80	3.00	May 2017
Storm (D2)	100mm	PVC	-	730.46	730.84	3.00	May 2017

Service Connection Location				Sanitary (m)	Storm (m)
Distance from downstream San MH	5433	towards upstream San MH	5434	9.38	
Distance from downstream Stm MH	4031	towards upstream Stm MH	4032		13.43
Distance from downstream San MH	5431	towards upstream San MH	5433	38.17	
Distance from downstream Stm MH	4029	towards upstream Stm MH	4031		42.14

Power	Size	Communications	Size	Cable	Size	Gas	Size
BC Hydro	75mm DB2	Telus	50mm DB2	Shaw	50mm DB2	FortisBC	42 PROP/P.E.
Underground Service		Underground Service		Underground Service			

Installed by:	Joe Roberts Constructiion	Survey Date:	-
Comments:			

NOT TO SCALE The information contained herein is for internal use only.
Not to be relied on unless confirmed by site inspection and/or investigation.

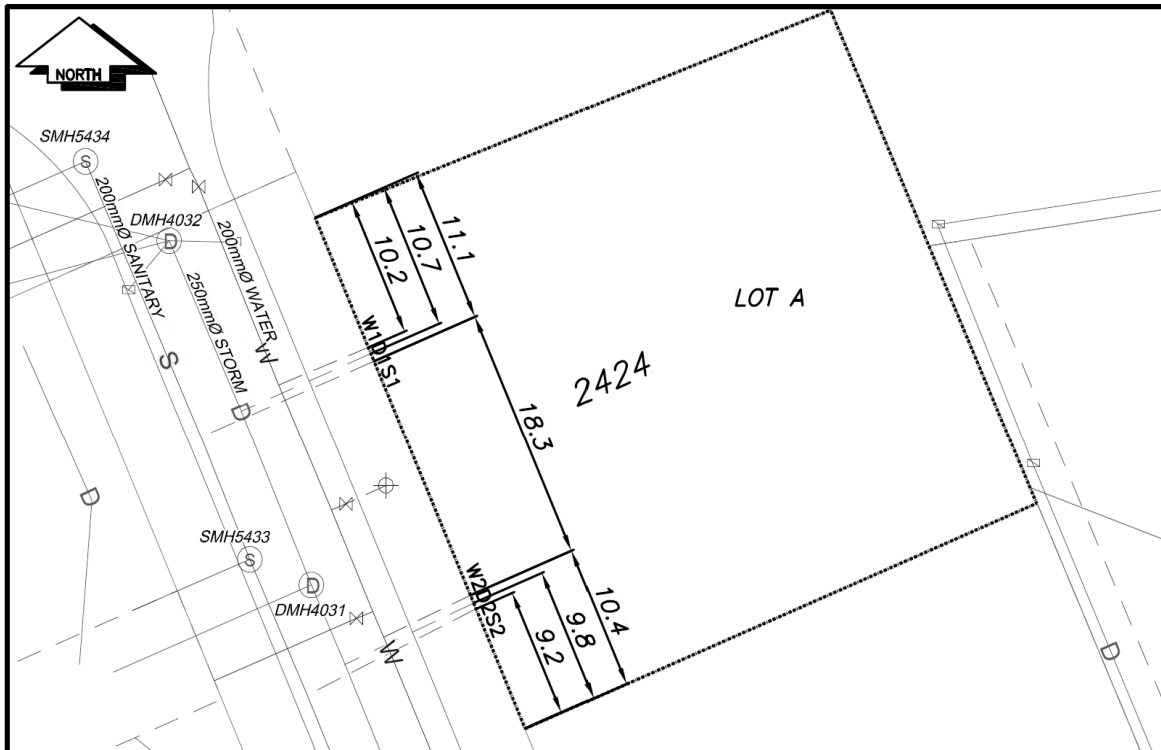

CS CURB STOP	W WATER SERVICE	D STORM SERVICE
CO CLEAN OUT	S SANITARY SERVICE	G GAS
WATER VALVE	FIRE HYDRANT	ENCUMBRANCE

NOT TO SCALE