



City of Prince George
History Sheet

PID:	031192220
SD/MU:	
WO:	

Civic Address: 1357 PG Pulpmill Rd

Legal Description: Lot: 1 District Lot: 823 Plan: EPP95004


Service Type	Diameter (mm)	Material	Invert Elev at main (m)	Invert Elev at property line (m)	Invert Elev at service end (m)	Distance into property (m)	Installation Date
Sanitary	N/A	N/A	-	-	-	-	-
Water	N/A	N/A	-	-	-	-	-
Storm	N/A	N/A	-	-	-	-	-

Service Connection Location					Sanitary (m)	Storm (m)
Distance from downstream San MH			-	towards upstream San MH	-	
Distance from downstream Stm MH			-	towards upstream Stm MH	-	

Power	Size	Communications	Size	Cable	Size	Gas	Size
BC Hydro	-	Telus	-	Shaw	-	FortisBC	-
Overhead Service		Overhead Service		Overhead Service			

Installed by:	Survey Date:	-
Comments:		

NOT TO SCALE The information contained herein is for internal use only.
Not to be relied on unless confirmed by site inspection and/or investigation.

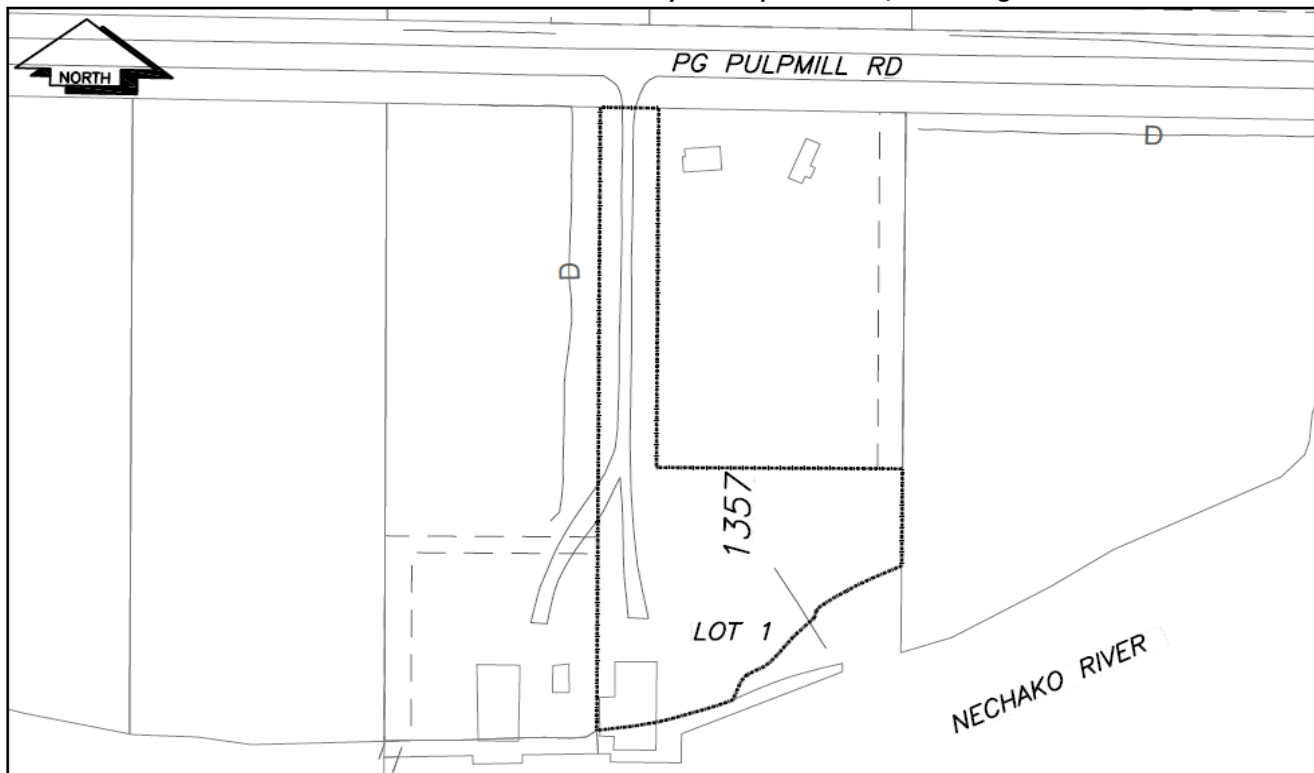

CS ^o	CURB STOP	— — — — —	WATER SERVICE	— — — — —	STORM SERVICE
CO ^o	CLEAN OUT	— — — — —	SANITARY SERVICE	— G —	GAS
⊗	WATER VALVE	XXXmm Ø	SANITARY HYDRANT	— — — — —	ENCUMBRANCE

NOT TO SCALE