



City of Prince George History Sheet

PID:	31192980
SD/MU:	
WO:	

Civic Address: 7411 Riggs Crescent

Legal Description: LOT 103, DL 748 & 750, PL EPP99266


Service Type	Diameter (mm)	Material	Invert Elev at main (m)	Invert Elev at property line (m)	Invert Elev at service end (m)	Distance into property (m)	Installation Date
Sanitary	200mm	PVC	664.88	665.72	665.91	7.59	2022
Water	300mm	PVC	664.07	664.89	665.20	2.32	2022
Storm	250mm	PVC	N/A	667.22	667.25	10.85	2022

Service Connection Location					Sanitary (m)	Storm (m)
Distance from upstream San MH	5282	towards downstream San MH	5282		0.00	-
Distance from downstream Stm MH	N/A	towards upstream Stm MH	N/A		-	0.00

Power	Size	Communications	Size	Cable	Size	Gas	Size
BC Hydro	2x100mm DB2	Telus	2x100mm DB2	Shaw	N/A	FortisBC	26mm
Underground Service		Underground Service					

Installed by:	Twin Rivers Developments Ltd.	Survey Date:	2022
Comments:			

NOT TO SCALE The information contained herein is for internal use only.
Not to be relied on unless confirmed by site inspection and/or investigation.

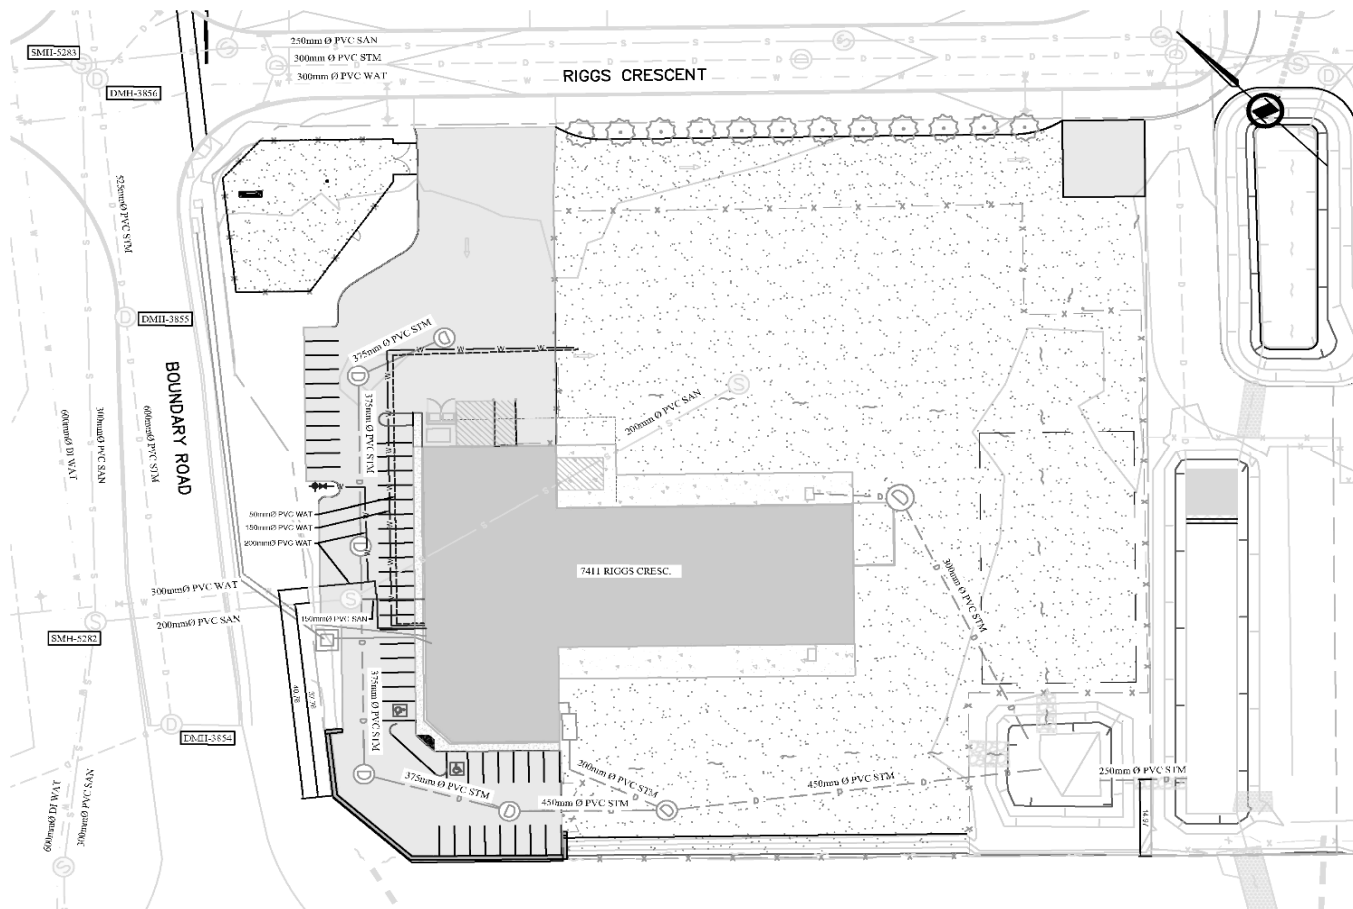

NOT TO SCALE