



City of Prince George History Sheet

PID:	031242685
	031242693
SD/MU:	
WO:	

Civic Address: 2003, 2005 Hwy 97

Legal Description: Lot: 1, 2 District Lot: 913 Plan: EPP87364


Service Type	Diameter (mm)	Material	Invert Elev at main (m)	Invert Elev at property line (m)	Invert Elev at service end (m)	Distance into property (m)	Installation Date
Sanitary	200mm	PVC	-	-	-	-	April 2007
Water	300mm	AC	-	-	-	-	January 1968
Storm	N/A	N/A	-	-	-	-	

Service Connection Location						Sanitary (m)	Storm (m)
200mm Sanitary service connected to San MH3849						-	
Distance from downstream Stm MH - towards upstream Stm MH -							

Power	Size	Communications	Size	Cable	Size	Gas	Size
BC Hydro	-	Telus	-	Shaw	-	FortisBC	-
Underground Service		Underground Service		Underground Service			

Installed by:	City of Prince George forces	Survey Date:	-
Comments:	Stormwater is managed on-site by infiltration.		

NOT TO SCALE The information contained herein is for internal use only.
Not to be relied on unless confirmed by site inspection and/or investigation.

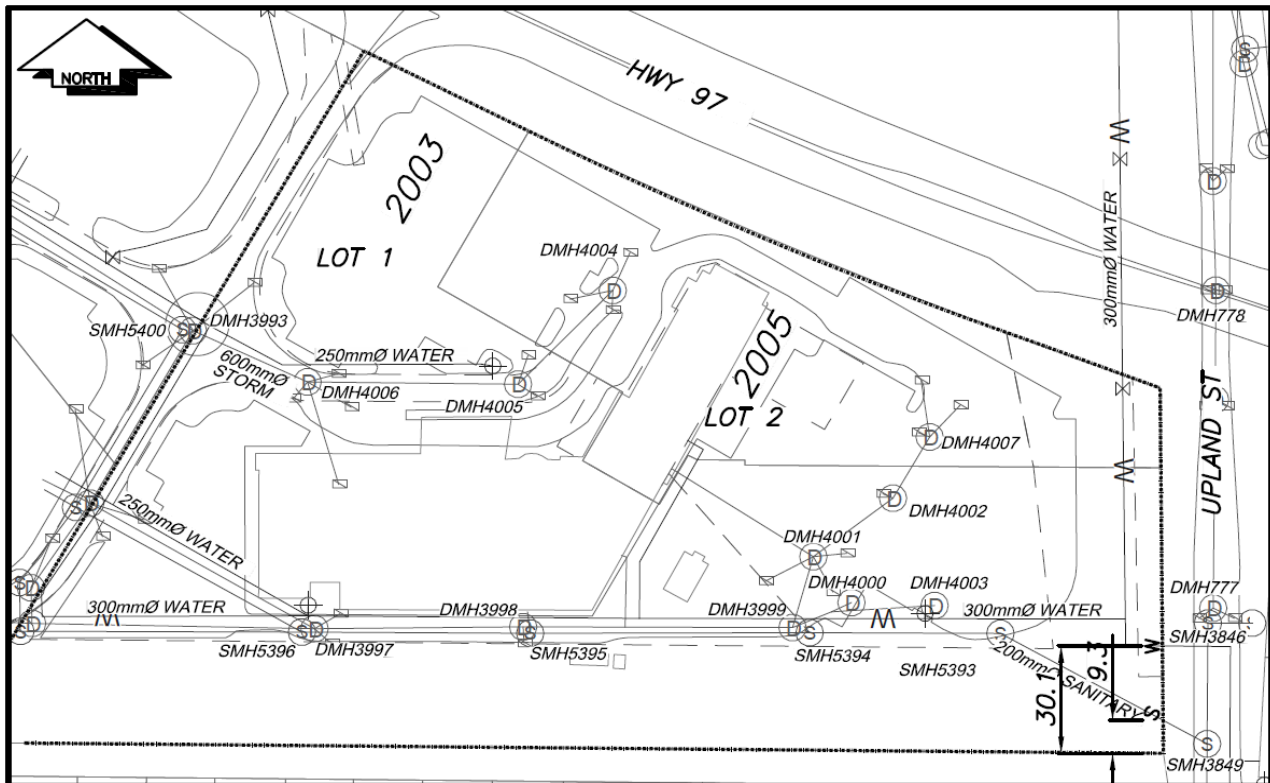

CS	CURB STOP	W	WATER SERVICE	D	STORM SERVICE
CO	CLEAN OUT	S	SANITARY SERVICE	G	GAS
X	WATER VALVE	F	FIRE HYDRANT	- - -	ENCUMBRANCE

NOT TO SCALE