

PID:	031-276-750
SD/MU:	SD100485
WO:	

CIVIC ADDRESS: 7279 FOXRIDGE AVE

LEGAL DESCRIPTION: LOT 6 DISTRICT LOT 2014 PLAN EPP96993


SERVICE TYPE	DIAMETER (mm)	MATERIAL	INVERT ELEV AT MAIN (m)	INVERT ELEV AT PROPERTY LINE (m)	INVERT ELEV AT SERVICE END (m)	COVER AT PROPERTY LINE (m)	DISTANCE INTO PROPERTY (m)	INSTALLATION DATE
SANITARY	100	PVC	580.03	580.33	580.37	2.49	3.00	SEPT 2017
WATER	19	COPPER	579.25	580.22	580.24	2.60	3.00	SEPT 2017
STORM	100	PVC	579.55	580.32	580.37	2.50	3.00	SEPT 2017

**ELECTRICAL / COMMUNICATIONS / GAS**

TYPE	PROVIDER	SIZE AND MATERIAL	LOCATION ( UNDERGROUND/ OVERHEAD)
ELECTRICAL	BC HYDRO	75mm DB2	UNDERGROUND
COMMUNICATION	TELUS	50mm DB2	UNDERGROUND
COMMUNICATION	SHAW	50mm DB2	UNDERGROUND
GAS	FORTISBC	42 PROP/P.E.	UNDERGROUND

INFORMATION SHEETS: L&M ENGINEERING LIMITED PROJECT NUMBER 1140-15	SURVEY DATE: SEPT 2017
INSTALLED BY: FORTWOOD HOMES LTD.	
COMMENTS:	

THE INFORMATION CONTAINED HEREIN IS FOR INTERNAL USE ONLY.  
NOT TO BE RELIED UPON UNLESS CONFIRMED BY SITE INVESTIGATION.

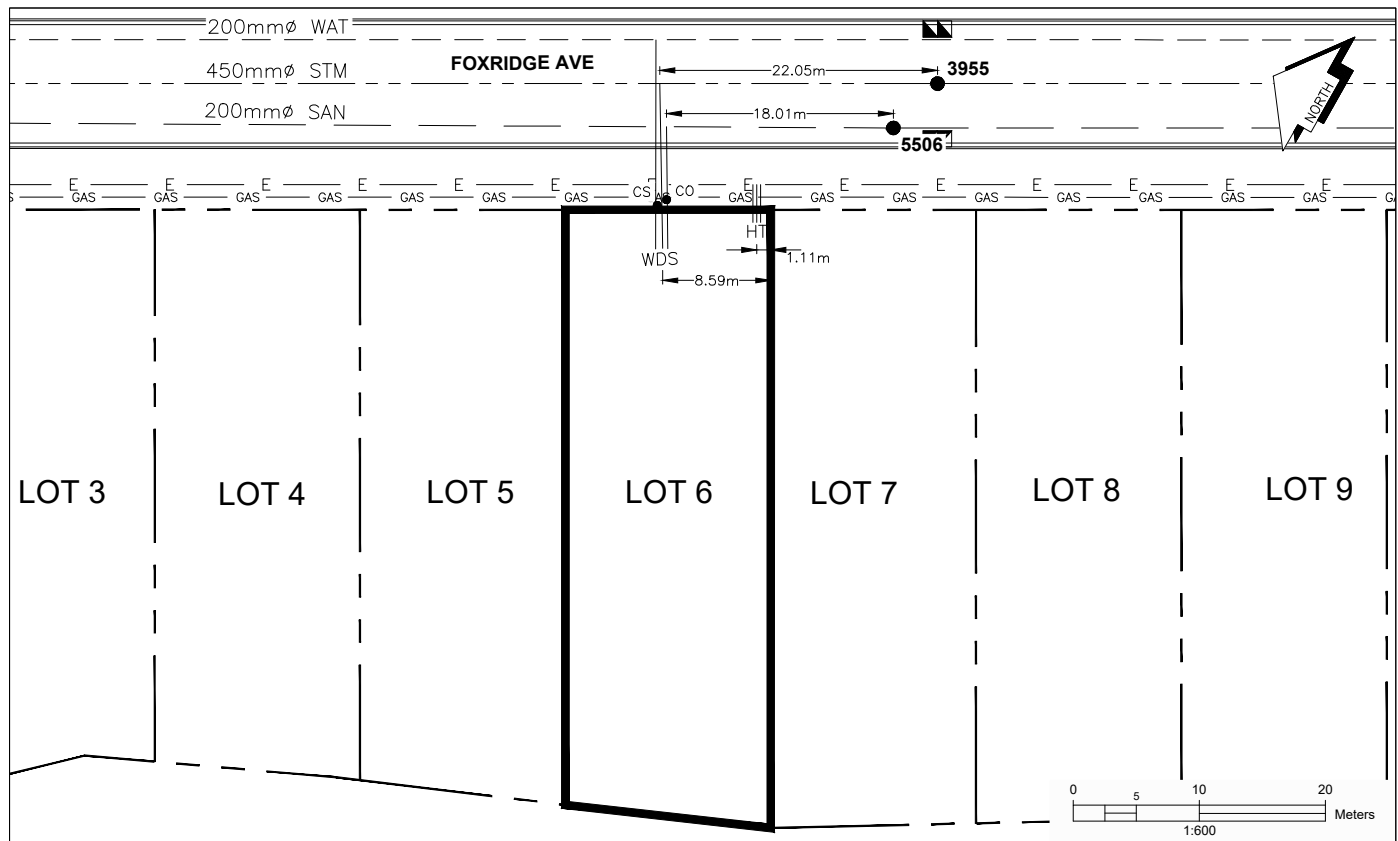

**LEGEND:**

CS	● CURB STOP	_____	SD	W	WATER SERVICE	_____	H	HYDRO SERVICE	_____	GAS	_____	GAS
CO	● CLEAN OUT	_____	SD		STORM SERVICE	_____	T	TELECOMMUNICATIONS	_____	E	_____	ELECTRICAL
		_____	SD		SANITARY SERVICE							