



CITY OF  
PRINCE GEORGE

# City of Prince George HISTORY SHEET

PID:	031-276-865
SD/MU:	SD100485
WO:	

CIVIC ADDRESS: 7531 HUSBAND PL

LEGAL DESCRIPTION: LOT 17 DISTRICT LOT 2014 PLAN EPP96993

SERVICE TYPE	DIAMETER (mm)	MATERIAL	INVERT ELEV AT MAIN (m)	INVERT ELEV AT PROPERTY LINE (m)	INVERT ELEV AT SERVICE END (m)	COVER AT PROPERTY LINE (m)	DISTANCE INTO PROPERTY (m)	INSTALLATION DATE
SANITARY	100	PVC	579.42	579.40	579.63	2.55	3.00	SEPT 2017
WATER	19	COPPER	578.80	579.44	579.51	2.51	3.00	SEPT 2017
STORM	100	PVC	578.88	579.48	579.61	2.47	3.00	SEPT 2017

## ELECTRICAL / COMMUNICATIONS / GAS

TYPE	PROVIDER	SIZE AND MATERIAL	LOCATION ( UNDERGROUND/ OVERHEAD)
ELECTRICAL	BC HYDRO	75mm DB2	UNDERGROUND
COMMUNICATION	TELUS	50mm DB2	UNDERGROUND
COMMUNICATION	SHAW	50mm DB2	UNDERGROUND
GAS	FORTISBC	42 PROP/P.E.	UNDERGROUND


INFORMATION SHEETS: L&M ENGINEERING LIMITED PROJECT NUMBER 1140-15

SURVEY DATE: SEPT 2017

INSTALLED BY: FORTWOOD HOMES LTD.

COMMENTS:

THE INFORMATION CONTAINED HEREIN IS FOR INTERNAL USE ONLY.  
NOT TO BE RELIED UPON UNLESS CONFIRMED BY SITE INVESTIGATION.

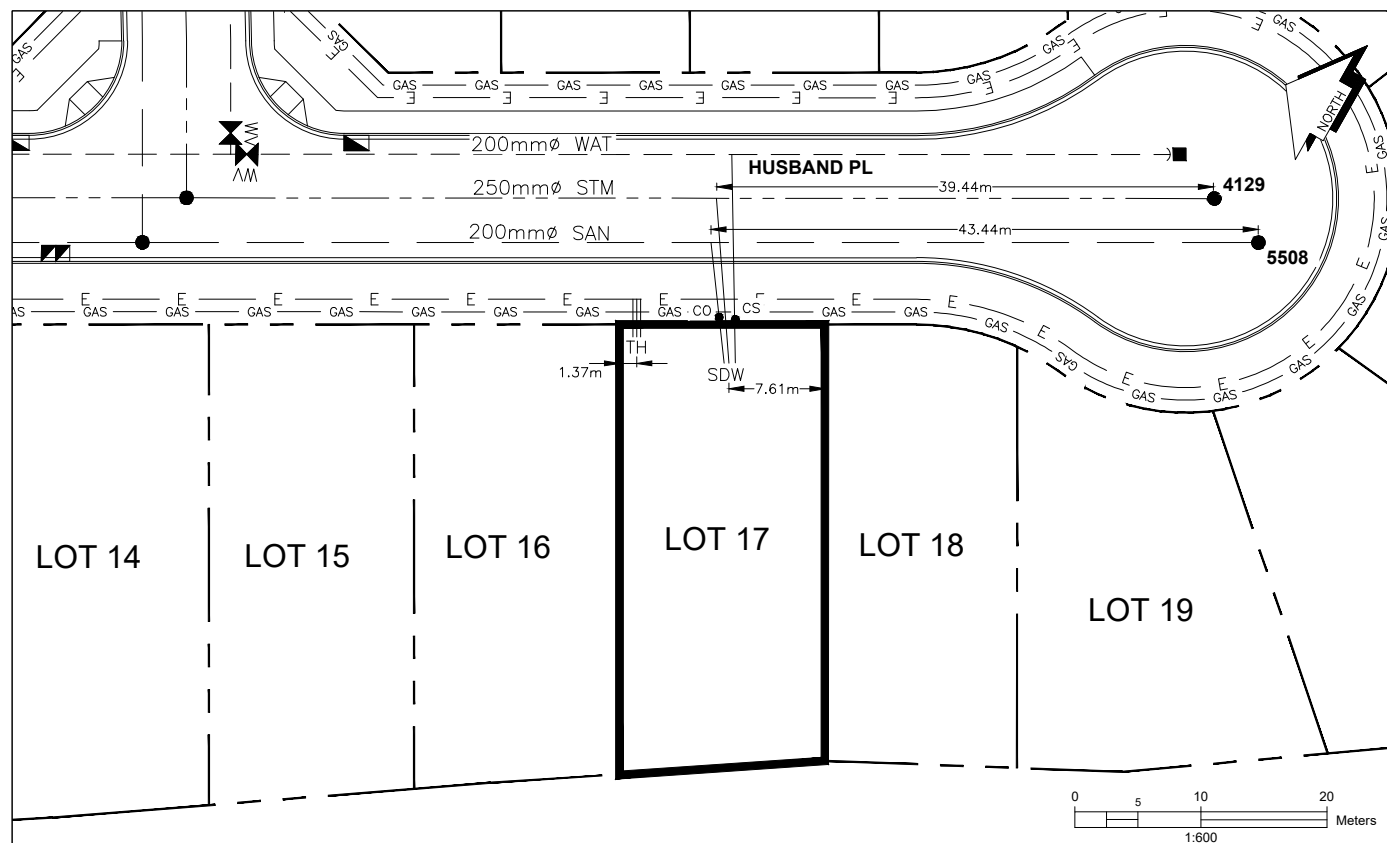

## LEGEND:

CS ● CURB STOP  
CO ● CLEAN OUT

— W — WATER SERVICE  
— S — STORM SERVICE  
— SAN — SANITARY SERVICE

— H — HYDRO SERVICE  
— T — TELECOMMUNICATIONS

— GAS — GAS  
— E — ELECTRICAL