



CITY OF  
PRINCE GEORGE

# City of Prince George HISTORY SHEET

PID:	031-276-962
SD/MU:	SD100485
WO:	

CIVIC ADDRESS: 7518 HUSBAND PL


LEGAL DESCRIPTION: LOT 27 DISTRICT LOT 2014 PLAN EPP96993

SERVICE TYPE	DIAMETER (mm)	MATERIAL	INVERT ELEV AT MAIN (m)	INVERT ELEV AT PROPERTY LINE (m)	INVERT ELEV AT SERVICE END (m)	COVER AT PROPERTY LINE (m)	DISTANCE INTO PROPERTY (m)	INSTALLATION DATE
SANITARY	100	PVC	579.19	579.55	579.63	2.18	3.00	SEPT 2017
WATER	19	COPPER	578.68	579.27	579.39	2.46	3.00	SEPT 2017
STORM	100	PVC	578.56	579.33	579.48	2.40	3.00	SEPT 2017

ELECTRICAL / COMMUNICATIONS / GAS			
TYPE	PROVIDER	SIZE AND MATERIAL	LOCATION ( UNDERGROUND/ OVERHEAD)
ELECTRICAL	BC HYDRO	75mm DB2	UNDERGROUND
COMMUNICATION	TELUS	50mm DB2	UNDERGROUND
COMMUNICATION	SHAW	50mm DB2	UNDERGROUND
GAS	FORTISBC	42 PROP/P.E.	UNDERGROUND

INFORMATION SHEETS: L&M ENGINEERING LIMITED PROJECT NUMBER 1140-15	SURVEY DATE: SEPT 2017
INSTALLED BY: FORTWOOD HOMES LTD.	
COMMENTS:	

THE INFORMATION CONTAINED HEREIN IS FOR INTERNAL USE ONLY.  
NOT TO BE RELIED UPON UNLESS CONFIRMED BY SITE INVESTIGATION.

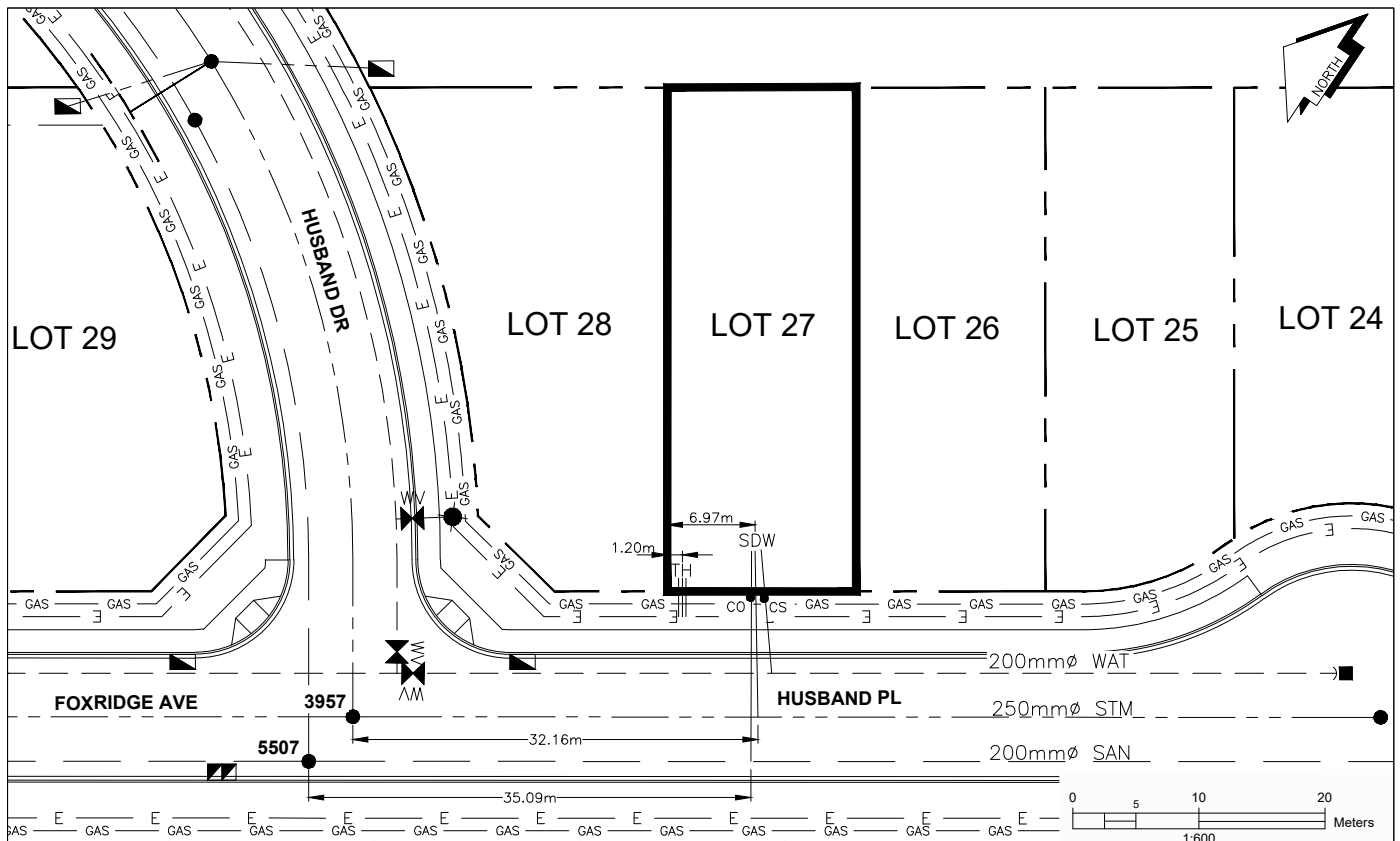

<b>LEGEND:</b>	CS ● CURB STOP	— W — WATER SERVICE	— H — HYDRO SERVICE	— GAS — GAS
	CO ● CLEAN OUT	— S — STORM SERVICE	— T — TELECOMMUNICATIONS	— E — ELECTRICAL
		— SD — SANITARY SERVICE		