



CITY OF
PRINCE GEORGE

City of Prince George HISTORY SHEET

| | |
|--------|-------------|
| PID: | 031-277-039 |
| SD/MU: | SD100485 |
| WO: | |

CIVIC ADDRESS: 7324 FOXRIDGE AVE


LEGAL DESCRIPTION: LOT 34 DISTRICT LOT 2014 PLAN EPP96993

| SERVICE TYPE | DIAMETER (mm) | MATERIAL | INVERT ELEV AT MAIN (m) | INVERT ELEV AT PROPERTY LINE (m) | INVERT ELEV AT SERVICE END (m) | COVER AT PROPERTY LINE (m) | DISTANCE INTO PROPERTY (m) | INSTALLATION DATE |
|--------------|---------------|----------|-------------------------|----------------------------------|--------------------------------|----------------------------|----------------------------|-------------------|
| SANITARY | 100 | PVC | 579.67 | 580.08 | 580.20 | 2.41 | 3.00 | AUG 2017 |
| WATER | 19 | COPPER | 579.42 | 580.09 | 580.13 | 2.40 | 3.00 | AUG 2017 |
| STORM | 100 | PVC | 579.13 | 580.15 | 580.19 | 2.34 | 3.00 | AUG 2017 |

| ELECTRICAL / COMMUNICATIONS / GAS | | | |
|-----------------------------------|----------|-------------------|-----------------------------------|
| TYPE | PROVIDER | SIZE AND MATERIAL | LOCATION (UNDERGROUND/ OVERHEAD) |
| ELECTRICAL | BC HYDRO | 75mm DB2 | UNDERGROUND |
| COMMUNICATION | TELUS | 50mm DB2 | UNDERGROUND |
| COMMUNICATION | SHAW | 50mm DB2 | UNDERGROUND |
| GAS | FORTISBC | 42 PROP/P.E. | UNDERGROUND |

| | |
|--|-----------------------|
| INFORMATION SHEETS: L&M ENGINEERING LIMITED PROJECT NUMBER 1140-15 | SURVEY DATE: AUG 2017 |
| INSTALLED BY: FORTWOOD HOMES LTD. | |
| COMMENTS: | |

THE INFORMATION CONTAINED HEREIN IS FOR INTERNAL USE ONLY.
NOT TO BE RELIED UPON UNLESS CONFIRMED BY SITE INVESTIGATION.

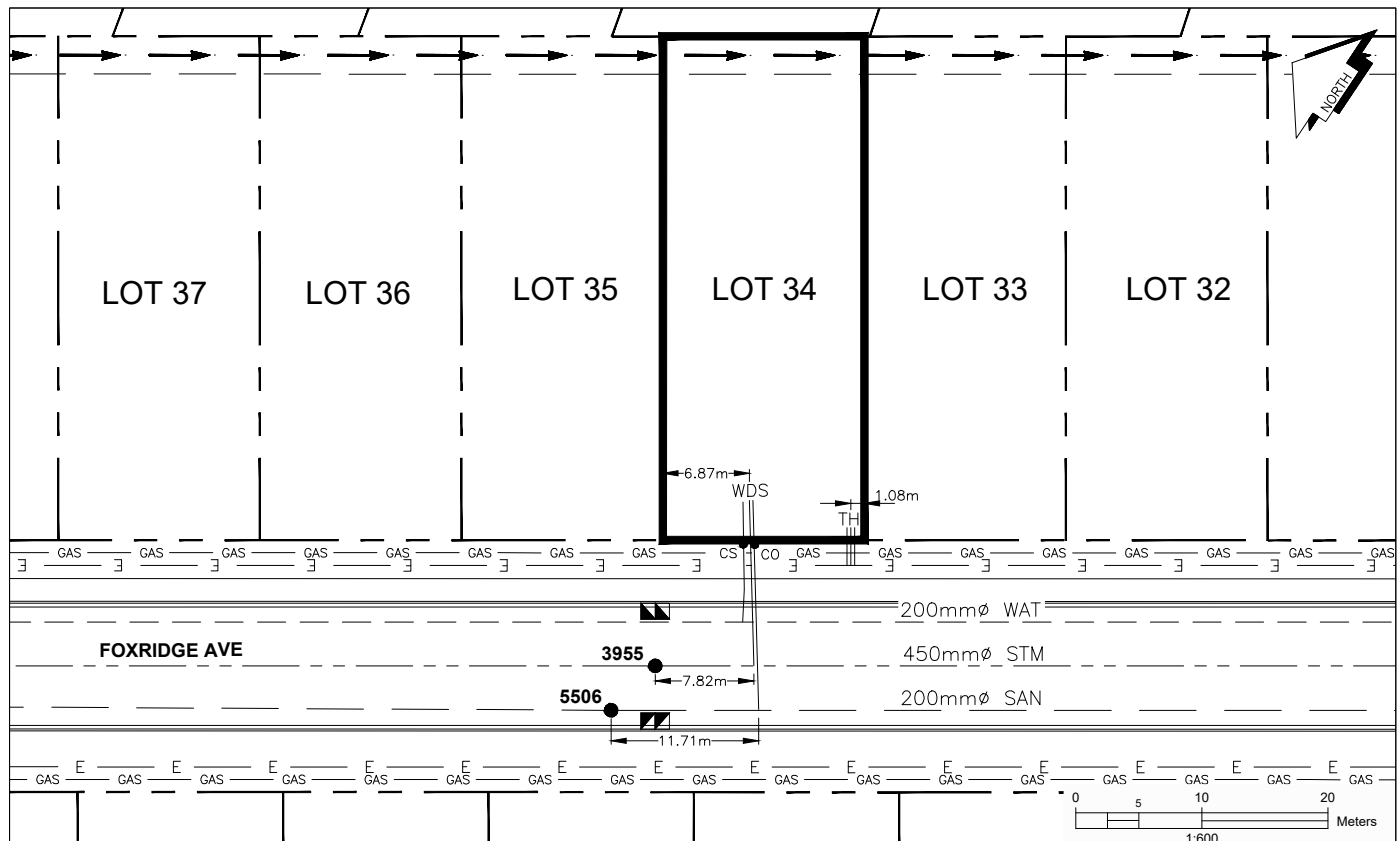

| | | | | |
|----------------|----------------|------------------------|--------------------------|------------------|
| LEGEND: | CS ● CURB STOP | — W — WATER SERVICE | — H — HYDRO SERVICE | — GAS — GAS |
| | CO ● CLEAN OUT | — S — STORM SERVICE | — T — TELECOMMUNICATIONS | — E — ELECTRICAL |
| | | — S — SANITARY SERVICE | | |