



CITY OF
PRINCE GEORGE

City of Prince George HISTORY SHEET

PID:	031-277-179
SD/MU:	SD100485
WO:	

CIVIC ADDRESS: 7427 HUSBAND DR

LEGAL DESCRIPTION: LOT 48 DISTRICT LOT 2014 PLAN EPP96993

SERVICE TYPE	DIAMETER (mm)	MATERIAL	INVERT ELEV AT MAIN (m)	INVERT ELEV AT PROPERTY LINE (m)	INVERT ELEV AT SERVICE END (m)	COVER AT PROPERTY LINE (m)	DISTANCE INTO PROPERTY (m)	INSTALLATION DATE
SANITARY	100	PVC	573.40	573.64	573.79	2.40	3.00	SEPT 2019
WATER	19	COPPER	572.73	573.62	573.72	2.42	3.00	SEPT 2019
STORM	100	PVC	571.22	573.74	573.85	2.30	3.00	SEPT 2019

SERVICE TYPE	DIAMETER (mm)	MATERIAL	INVERT ELEV AT MAIN (m)	INVERT ELEV AT PROPERTY LINE (m)	INVERT ELEV AT SERVICE END (m)	COVER AT PROPERTY LINE (m)	DISTANCE INTO PROPERTY (m)	INSTALLATION DATE
SANITARY	100	PVC	573.99	574.31	574.41	2.48	3.00	SEPT 2019
WATER	19	COPPER	573.36	574.29	574.37	2.50	3.00	SEPT 2019
STORM	100	PVC	572.83	574.42	574.51	2.37	3.00	SEPT 2019

ELECTRICAL / COMMUNICATIONS / GAS


TYPE	PROVIDER	SIZE AND MATERIAL	LOCATION (UNDERGROUND/ OVERHEAD)
ELECTRICAL	BC HYDRO	75mm DB2	UNDERGROUND
COMMUNICATION	TELUS	50mm DB2	UNDERGROUND
COMMUNICATION	SHAW	50mm DB2	UNDERGROUND
GAS	FORTISBC	42 PROP/P.E.	UNDERGROUND

INFORMATION SHEETS: L&M ENGINEERING LIMITED PROJECT NUMBER 1140-15

SURVEY DATE: SEPT 2019

INSTALLED BY: FORTWOOD HOMES LTD.

THE INFORMATION CONTAINED HEREIN IS FOR INTERNAL USE ONLY.
NOT TO BE RELIED UPON UNLESS CONFIRMED BY SITE INVESTIGATION.

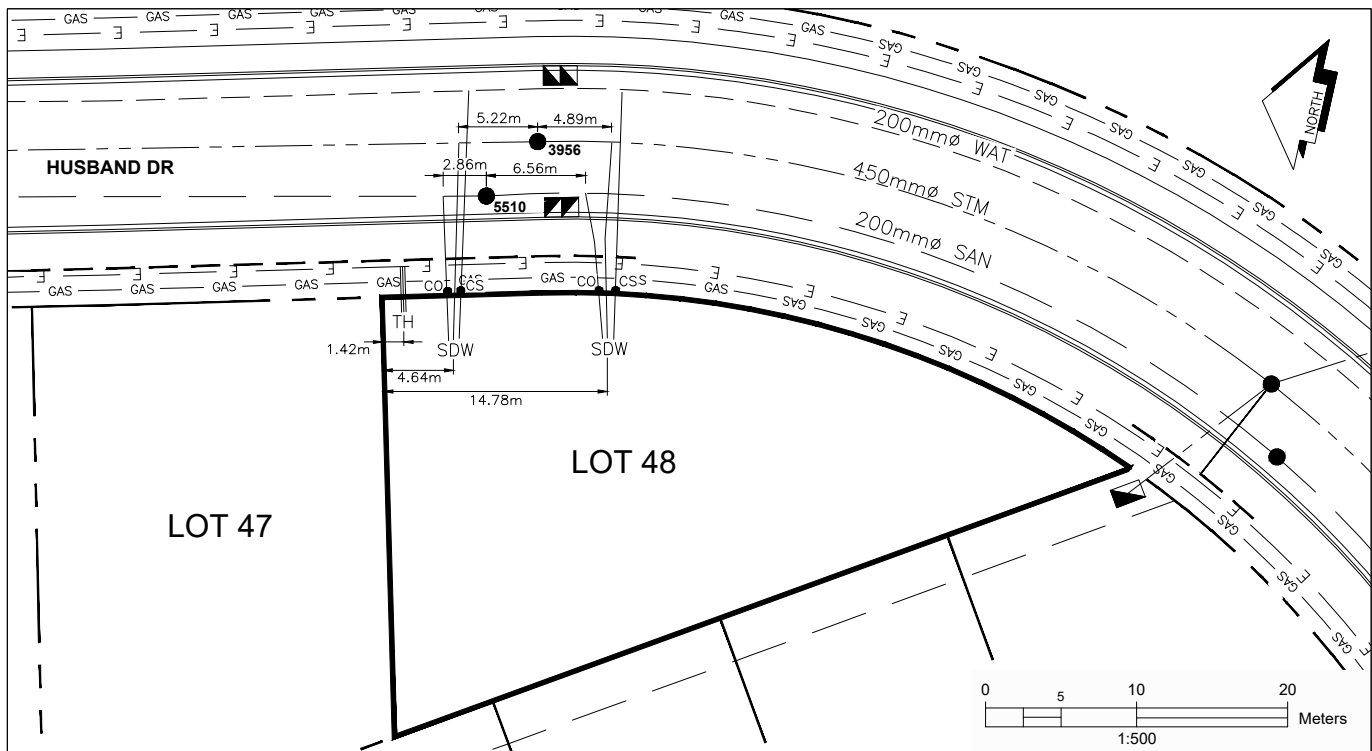

LEGEND:

CS ● CURB STOP	— W — WATER SERVICE	— H — HYDRO SERVICE	— GAS — GAS
CO ● CLEAN OUT	— S — STORM SERVICE	— T — TELECOMMUNICATIONS	— E — ELECTRICAL
	— SAN — SANITARY SERVICE		