



City of Prince George  
**History Sheet**

PID:	031280862
SD/MU:	
WO:	

Civic Address: 2808 Wildwood Cres

Legal Description: Lot: Part DL 4046 shown on EPP1073 District Lot: 4046 Plan: EPP107326


Service Type	Diameter (mm)	Material	Invert Elev at main (m)	Invert Elev at property line (m)	Invert Elev at service end (m)	Distance into property (m)	Installation Date
Sanitary	N/A	N/A	-	-	-	-	-
Water	N/A	N/A	-	-	-	-	
Storm	N/A	N/A	-	-	-	-	

Service Connection Location					Sanitary (m)	Storm (m)
Distance from downstream San MH			-	towards upstream San MH	-	
Distance from downstream Stm MH			-	towards upstream Stm MH	-	

Power	Size	Communications	Size	Cable	Size	Gas	Size
BC Hydro	-	Telus	-	Shaw	-	FortisBC	-
Overhead Service		Overhead Service		Overhead Service			

Installed by:	Survey Date:	-
Comments:		

**NOT TO SCALE** The information contained herein is for internal use only.  
Not to be relied on unless confirmed by site inspection and/or investigation.

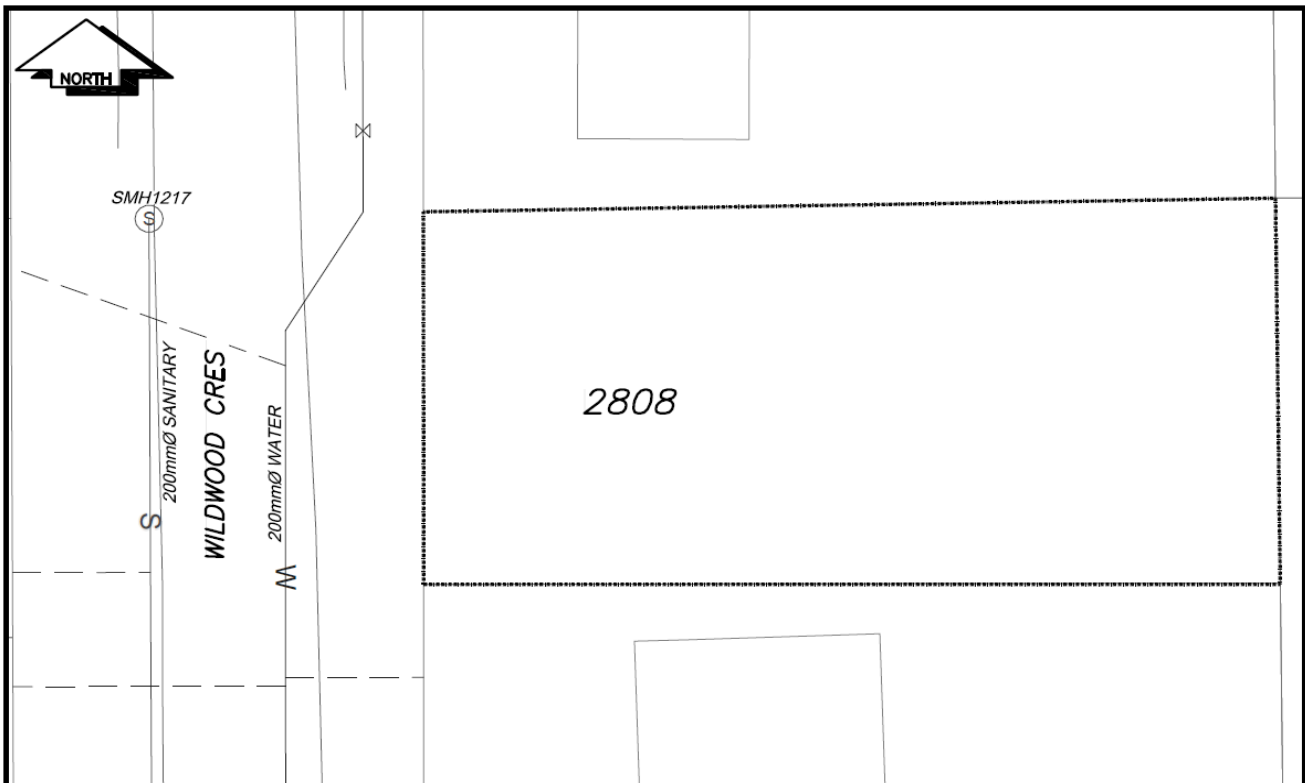

CS <sup>o</sup>	CURB STOP	—	WATER SERVICE	—	STORM SERVICE
CO <sup>o</sup>	CLEAN OUT	---	SANITARY SERVICE	—G—	GAS
⊗	WATER VALVE	⊗	FIRE HYDRANT	---	ENCUMBRANCE

**NOT TO SCALE**