



CITY OF  
PRINCE GEORGE

## City of Prince George HISTORY SHEET

|        |             |
|--------|-------------|
| PID:   | 031-355-277 |
| SD/MU: | SD100629    |
| WO:    |             |

CIVIC ADDRESS: 5578 VENTA DRIVE WEST


LEGAL DESCRIPTION: LOT 2 DISTRICT LOT 2425 PLAN EPP107750

| SERVICE TYPE | DIAMETER (mm) | MATERIAL | INVERT ELEV AT MAIN (m) | INVERT ELEV AT PROPERTY LINE (m) | INVERT ELEV AT SERVICE END (m) | COVER AT PROPERTY LINE (m) | DISTANCE INTO PROPERTY (m) | INSTALLATION DATE |
|--------------|---------------|----------|-------------------------|----------------------------------|--------------------------------|----------------------------|----------------------------|-------------------|
| SANITARY     | 100           | PVC      | 763.04                  | 763.49                           | 763.57                         | 2.10                       | 3.00                       | SEPT 2020         |
| WATER        | 19            | COPPER   | 762.37                  | 763.47                           | 763.67                         | 2.20                       | 3.00                       | SEPT 2020         |
| STORM        | 100           | PVC      | 763.22                  | 763.57                           | 763.62                         | 2.02                       | 3.00                       | SEPT 2020         |

| ELECTRICAL / COMMUNICATIONS / GAS |          |                   |                                   |
|-----------------------------------|----------|-------------------|-----------------------------------|
| TYPE                              | PROVIDER | SIZE AND MATERIAL | LOCATION ( UNDERGROUND/ OVERHEAD) |
| ELECTRICAL                        | BC HYDRO | 75mm DB2          | UNDERGROUND                       |
| COMMUNICATION                     | TELUS    | 50mm DB2          | UNDERGROUND                       |
| COMMUNICATION                     | SHAW     | 50mm DB2          | UNDERGROUND                       |
| GAS                               | FORTISBC | 42 PROP/P.E.      | UNDERGROUND                       |

|  |                        |
|--|------------------------|
| INFORMATION SHEETS: L&M ENGINEERING LIMITED PROJECT NUMBER 1631-03 | SURVEY DATE: SEPT 2020 |
| INSTALLED BY: JOE ROBERTS CONSTRUCTION & CONSULTING SERVICES LTD.  |                        |
| COMMENTS:  |                        |

THE INFORMATION CONTAINED HEREIN IS FOR INTERNAL USE ONLY.  
NOT TO BE RELIED UPON UNLESS CONFIRMED BY SITE INVESTIGATION.

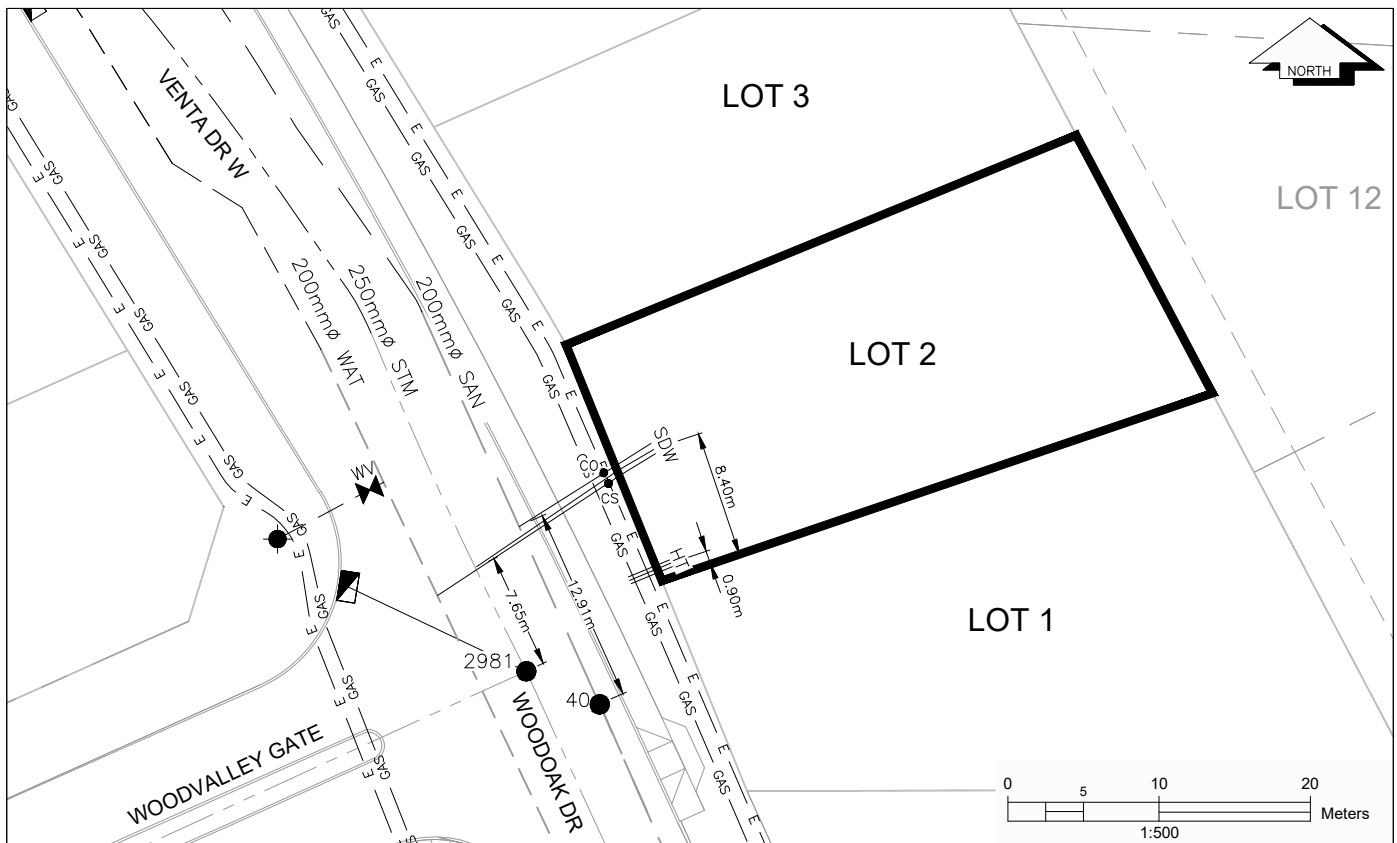

|                |              |                    |                      |              |
|----------------|--------------|--------------------|----------------------|--------------|
| <b>LEGEND:</b> | CS CURB STOP | W WATER SERVICE    | H HYDRO SERVICE      | G GAS        |
|                | CO CLEAN OUT | S D STORM SERVICE  | T TELECOMMUNICATIONS | E ELECTRICAL |
|                |              | S SANITARY SERVICE |                      |              |