



CITY OF
PRINCE GEORGE

City of Prince George HISTORY SHEET

PID:	031-355-404
SD/MU:	SD100629
WO:	

CIVIC ADDRESS: 5559 VENTA DRIVE WEST


LEGAL DESCRIPTION: LOT 15 DISTRICT LOT 2425 PLAN EPP107750

SERVICE TYPE	DIAMETER (mm)	MATERIAL	INVERT ELEV AT MAIN (m)	INVERT ELEV AT PROPERTY LINE (m)	INVERT ELEV AT SERVICE END (m)	COVER AT PROPERTY LINE (m)	DISTANCE INTO PROPERTY (m)	INSTALLATION DATE
SANITARY	100	PVC	763.51	763.92	763.95	2.03	3.00	AUG 2020
WATER	19	COPPER	762.97	763.64	763.76	2.41	3.00	AUG 2020
STORM	100	PVC	763.67	763.93	763.96	2.03	3.00	AUG 2020

ELECTRICAL / COMMUNICATIONS / GAS			
TYPE	PROVIDER	SIZE AND MATERIAL	LOCATION (UNDERGROUND/ OVERHEAD)
ELECTRICAL	BC HYDRO	75mm DB2	UNDERGROUND
COMMUNICATION	TELUS	50mm DB2	UNDERGROUND
COMMUNICATION	SHAW	50mm DB2	UNDERGROUND
GAS	FORTISBC	42 PROP/P.E.	UNDERGROUND

INFORMATION SHEETS: L&M ENGINEERING LIMITED PROJECT NUMBER 1631-03	SURVEY DATE: AUG 2020
INSTALLED BY: JOE ROBERTS CONSTRUCTION & CONSULTING SERVICES LTD.	
COMMENTS:	

THE INFORMATION CONTAINED HEREIN IS FOR INTERNAL USE ONLY.
NOT TO BE RELIED UPON UNLESS CONFIRMED BY SITE INVESTIGATION.

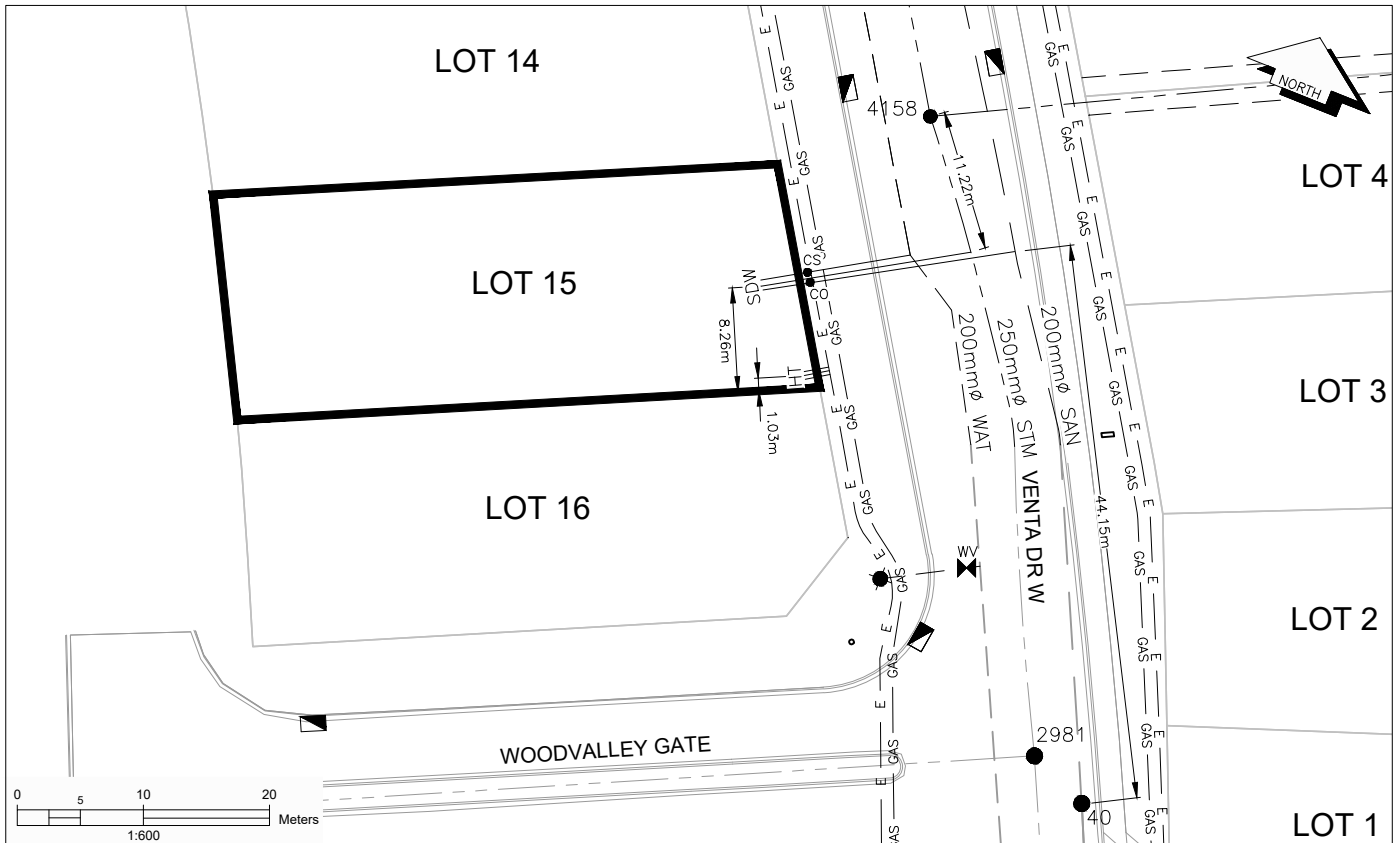

LEGEND:	CS CURB STOP	W WATER SERVICE	H HYDRO SERVICE	GAS GAS
	CO CLEAN OUT	S STORM SERVICE	T TELECOMMUNICATIONS	E ELECTRICAL
		S SANITARY SERVICE		