



# City of Prince George HISTORY SHEET

CITY OF  
PRINCE GEORGE

PID:	031-540-287
SD/MU:	
WO:	

CIVIC ADDRESS: 7000 BOUNDARY ROAD


LEGAL DESCRIPTION: LOT A DISTRICT LOT 748 PLAN EPP95567

SERVICE TYPE	DIAMETER (mm)	MATERIAL	INVERT ELEV AT MAIN (m)	INVERT ELEV AT PROPERTY LINE (m)	INVERT ELEV AT SERVICE END (m)	COVER AT PROPERTY LINE (m)	DISTANCE INTO PROPERTY (m)	INSTALLATION DATE
SANITARY	150	HDPE	668.90	670.17	670.55	2.83	6.00	AUG 2021
WATER	200	PVC	669.52	669.86	667.93	3.14	6.00	AUG 2021
STORM	250	PVC	670.50	671.02	671.27	2.37	12.70	AUG 2021

ELECTRICAL / COMMUNICATIONS / GAS			
TYPE	PROVIDER	SIZE AND MATERIAL	LOCATION ( UNDERGROUND/ OVERHEAD)
ELECTRICAL	BC HYDRO	75mm DB2	UNDERGROUND
COMMUNICATION	TELUS	50mm DB2	UNDERGROUND
COMMUNICATION	SHAW	75mm DB2	UNDERGROUND
GAS	FORTISBC	42 PROP/P.E.	UNDERGROUND

INFORMATION SHEETS: L&M ENGINEERING LIMITED PROJECT NUMBER 1825-01	SURVEY DATE: SEP 2023
INSTALLED BY: SEKO CONSTRUCTION	
COMMENTS:	

THE INFORMATION CONTAINED HEREIN IS FOR INTERNAL USE ONLY.  
NOT TO BE RELIED UPON UNLESS CONFIRMED BY SITE INVESTIGATION.

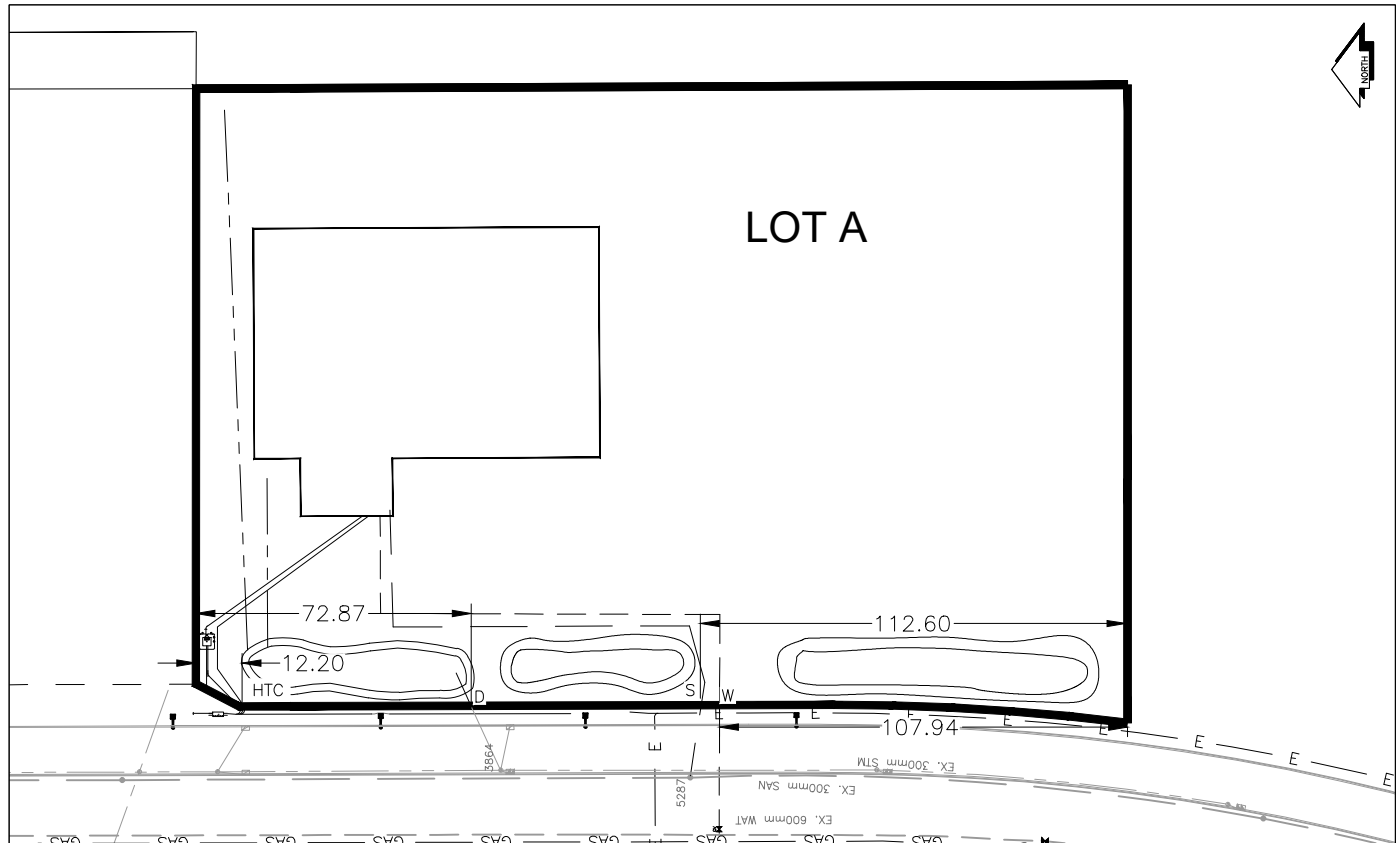

LEGEND:			
CS ● CURB STOP	— W — WATER SERVICE	— H — HYDRO SERVICE	— GAS — GAS
CO ● CLEAN OUT	— S D W — STORM SERVICE	— T — TELECOMMUNICATIONS	— E — ELECTRICAL
	— S — SANITARY SERVICE		