
Lot Services Sketch



Civic Address: 3472 PARKVIEW CRES Legal Description: Lot: C District Lot: 2003 Plan: EPP101957

(mm)	Material	Invert Elev @ Main (m)		rt Elev @ rty Line (m)	Invert Elev @ Service End (m)	Distance into Property (m)	Installation Date
100	PVC	708.07	-	708.22	708.66	2.63	July 2012
19	COPPER	707.10	-	708.22	708.56	2.71	July 2012
100	PVC	707.88	-	708.22	708.65	2.63	July 2012
Sanitary Service Connection Location Notes Storm Service Connection Location Notes						Notes	
Distance from downstream SAN MH #5221: 72.42m Distance from			downstream STM MH #3782: 70.29m				
Distance to upstream SAN MH #5227: 19.66m				Distance to upstream STM MH #3781: 16.66m			
	19 100 7 Service Co ream SAN MH #	19 COPPER 100 PVC Service Connection Loc ream SAN MH #5221: 72.42m	19 COPPER 707.10 100 PVC 707.88 Service Connection Location Notes ream SAN MH #5221: 72.42m	19 COPPER 707.10 100 PVC 707.88 2 Service Connection Location Notes ream SAN MH #5221: 72.42m	19 COPPER 707.10 708.22 100 PVC 707.88 708.22 Service Connection Location Notes Stance from on the st	19 COPPER 707.10 708.22 708.56 100 PVC 707.88 708.22 708.65 V Service Connection Location Notes Storm Service Connection Location Notes ream SAN MH #5221: 72.42m Distance from downstream STM MH #3	19 COPPER 707.10 708.22 708.56 2.71 100 PVC 707.88 708.22 708.65 2.63 2 Service Connection Location Notes Storm Service Connection Location ream SAN MH #5221: 72.42m Distance from downstream STM MH #3782: 70.29m

Power		Communications	Cable	Gas	Gas				
BC Hydro		TELUS	Shaw Cable	FortisBC					
Undergr	ound Service	Underground Service	Underground Service	Underground Service					
Installation By:	Sunland Utilities LTD.				May 2012				
Comments:									
Ref. Dwgs. L&M Engineering LTD. Job. 1273-17-04 DWGS. Survey Book Ref.: 1273-14-04									

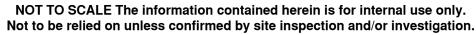

VALVE #7078 HYDRANT #2616 VALVE #7079 VALVE #7079 D-MH #3781 S-MH #5227	LOT C	
		- UNDERGROUND GAS LINE
WATER HYDRANT LEAD, VALVE, HYI		- UNDERGROUND ELECTRICAL
	Г (CO) <i>Т</i>	- UNDERGROUND TEL
– – – – – – – – – D STORM SERVICE	C	- UNDERGROUND CABLE
ROAD EDGE		- ENCUMBRANCE