



CITY OF
PRINCE GEORGE

City of Prince George

HISTORY SHEET

PID:	031-658-075
SD/MU:	SD100547
WO:	

CIVIC ADDRESS: 4177 UNIVERSITY HEIGHTS DR

LEGAL DESCRIPTION: LOT 49 DISTRICT LOT 905 PLAN EPP108995

SERVICE TYPE	DIAMETER (mm)	MATERIAL	INVERT ELEV AT MAIN (m)	INVERT ELEV AT PROPERTY LINE (m)	INVERT ELEV AT SERVICE END (m)	COVER AT PROPERTY LINE (m)	DISTANCE INTO PROPERTY (m)	INSTALLATION DATE
SANITARY	100	PVC	713.07	713.73	713.86	2.11	3.00	JUNE 2021
WATER	19	COPPER	712.68	713.78	713.82	2.20	3.00	JUNE 2021
STORM	100	PVC	713.22	713.75	713.83	2.12	3.00	JUNE 2021

ELECTRICAL / COMMUNICATIONS / GAS

TYPE	PROVIDER	SIZE AND MATERIAL	LOCATION (UNDERGROUND/ OVERHEAD)
ELECTRICAL	BC HYDRO	75mm DB2	UNDERGROUND
COMMUNICATION	TELUS	50mm DB2	UNDERGROUND
COMMUNICATION	SHAW	50mm DB2	UNDERGROUND
GAS	FORTISBC	42 PROP/P.E.	UNDERGROUND


INFORMATION SHEETS: L&M ENGINEERING LIMITED PROJECT NUMBER 1273-24

SURVEY DATE: JUNE 2021

INSTALLED BY: JOE ROBERTS CONSTRUCTION & CONSULTING SERVICES LTD.

COMMENTS:

THE INFORMATION CONTAINED HEREIN IS FOR INTERNAL USE ONLY.
NOT TO BE RELIED UPON UNLESS CONFIRMED BY SITE INVESTIGATION.

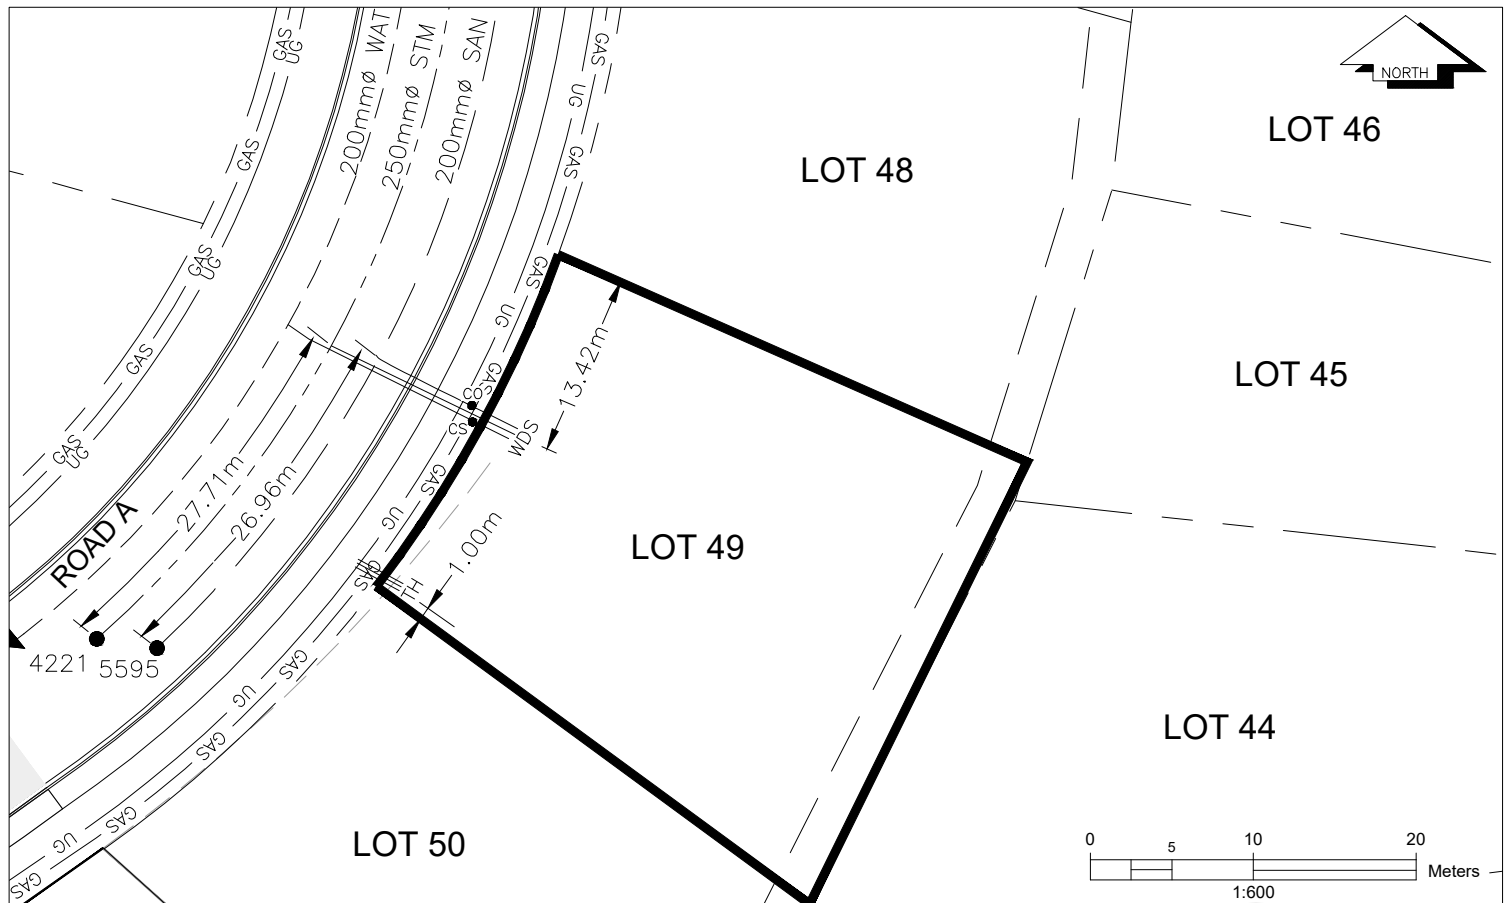

LEGEND:	CS CURB STOP	— W — WATER SERVICE	— H — HYDRO SERVICE	— GAS — GAS
CO CLEAN OUT	— S — STORM SERVICE	— C — COMMUNICATION SERVICES	— UG — SHALLOW UTILITIES	
	— S — SANITARY SERVICE			