 



Legal Description: Lot: A District Lot: 933 Plan: EPP114197

Service Type	Diameter (mm)	Material	Invert Elev @ Main (m)	Invert Elev @ Property Line (m)		Invert Elev (Service End (-	nce into erty (m)	Installation Date		
Sanitary	100	PVC	582.80	583.05		583.07		1.5	October 2020		
Water	19	COPPER	-	-		-		-	December 1954		
Storm	200	PVC	-	-		-		-	October 2020		
Sanita	Storm Service Connection Location Notes										
Distance from downstream SAN MH #3686: 15.98m					Distance from downstream STM MH #4179: 0.00m						
Distance to upstream SAN MH #3872: 29.74m					Distance to upstream STM MH #4179: 0.00m						
			Mise	cellaned	ous Utilities						
Po	wer	С	Communications			Cable			Gas		
BC Hydro			TELUS		Shaw Cable			FortisBC			
Overhea	d Service	C	Overhead Service			Overhead Service			Underground Service		
Installation By:	Ilation By: City of Prince George				Draft Date:	2022-10-11	Survey Dat	e: 2020-10-15			
I				Comm	nents:				1		
Curb Stop is ~14.5r	n North from the S	South West corne	r of Lot A. Storm S	Service is ~	20.3m North fro	m the South West	corner of Lot A	A. Clean Out is	~ 21.3m North		
from the South Wes	st corner of Lot A.	MU #: 102344. W	VO #: 103948 / 501	19921.							
						n is for interna	-				



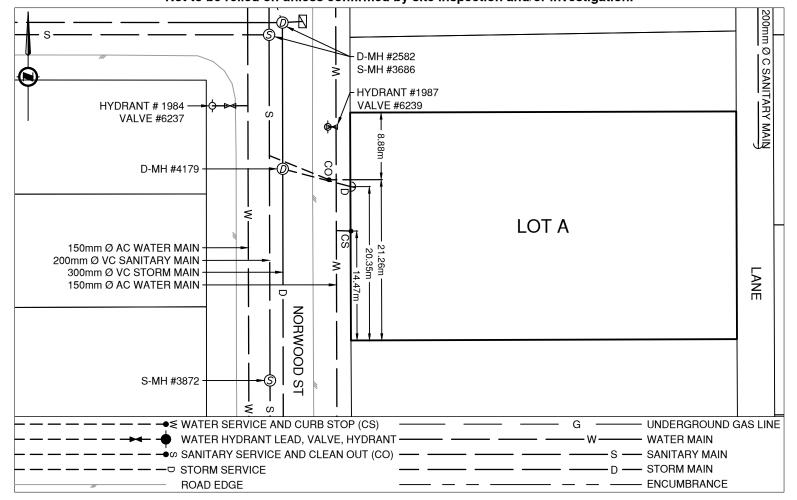

PID: 031668216