



CITY OF  
PRINCE GEORGE

# City of Prince George HISTORY SHEET

PID:	031682685 PID
SD/MU:	100671
WO:	

CIVIC ADDRESS: 1975 Bowser Ave


LEGAL DESCRIPTION: Lot 1 District Lot 343 Plan EPP113718

SERVICE TYPE	DIAMETER (mm)	MATERIAL	INVERT ELEV AT MAIN (m)	INVERT ELEV AT PROPERTY LINE (m)	INVERT ELEV AT SERVICE END (m)	COVER AT PROPERTY LINE (m)	DISTANCE INTO PROPERTY (m)	INSTALLATION DATE
SANITARY 1	200mm	PVC	566.40	567.29	N/A	3.79	N/A	MAY 2021
SANITARY 2	200mm	PVC	566.40	566.88	N/A	2.63	N/A	MAY 2021
WATER	200mm	PVC	567.72	567.71	N/A	2.93	N/A	AUGUST 2021
STORM	ONSITE INFILTRATION SYSTEM							

ELECTRICAL / COMMUNICATIONS / GAS			
TYPE	PROVIDER	SIZE AND MATERIAL	LOCATION ( UNDERGROUND/ OVERHEAD)
ELECTRICAL	BC HYDRO	3x75mm DB2	UNDERGROUND
COMMUNICATION	TELUS	2x100mm DB2	UNDERGROUND
COMMUNICATION	SHAW	2x75mm DB2	UNDERGROUND
GAS	FORTISBC		UNDERGROUND

INFORMATION SHEETS: L&M ENGINEERING LIMITED PROJECT NUMBER 1559-03	SURVEY DATE: SEPTEMBER 2021
INSTALLED BY: IDL PROJECTS	
COMMENTS:	

THE INFORMATION CONTAINED HEREIN IS FOR INTERNAL USE ONLY.  
NOT TO BE RELIED UPON UNLESS CONFIRMED BY SITE INVESTIGATION.

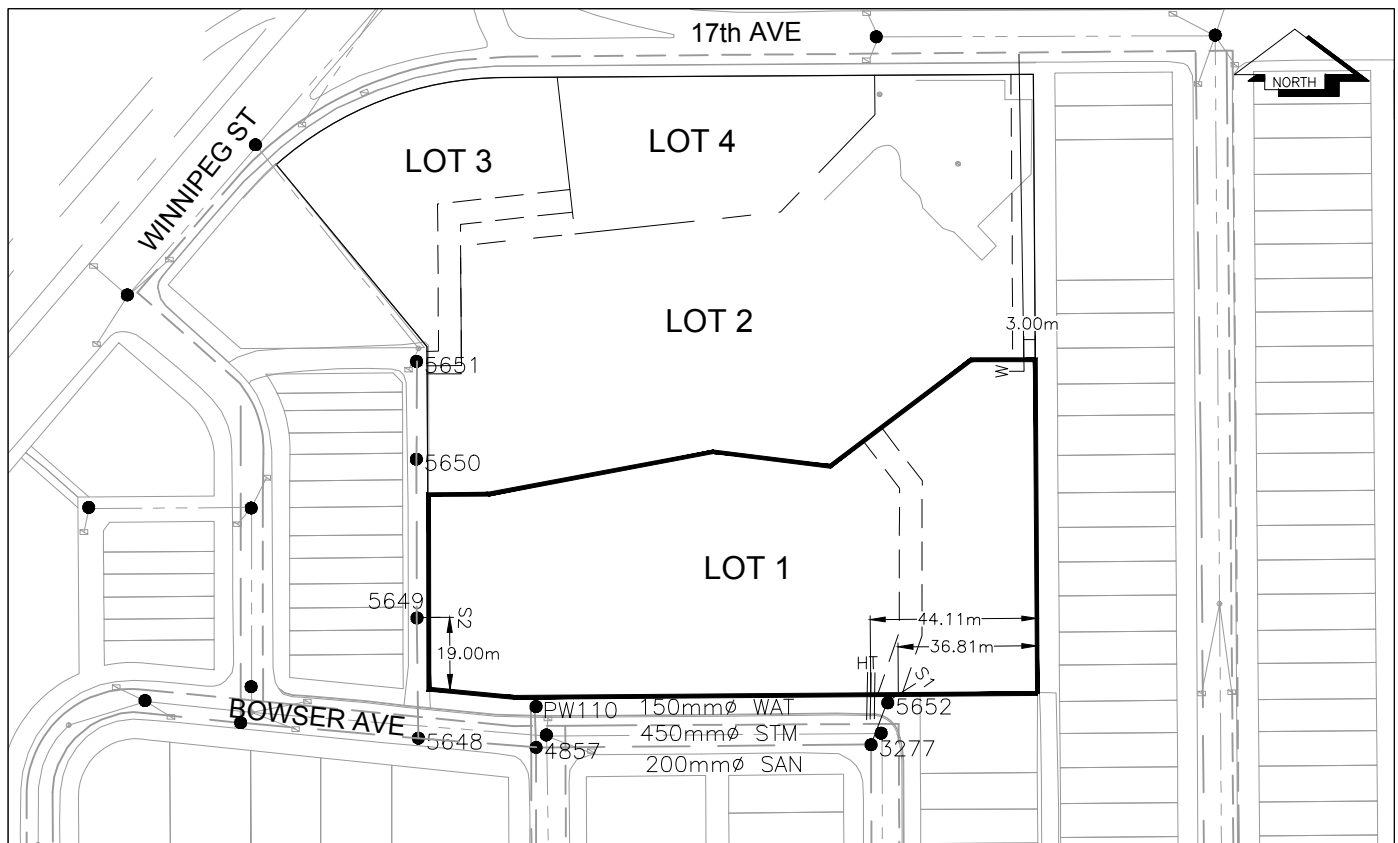

LEGEND:	CS CURB STOP	— S — WATER SERVICE	— H — HYDRO SERVICE	— GAS — GAS
	CO CLEAN OUT	— S — STORM SERVICE	— T — TELECOMMUNICATIONS	— UG — GAS SHALLOW UTILITIES
		— S — SANITARY SERVICE		