



CITY OF
PRINCE GEORGE

City of Prince George HISTORY SHEET

PID:	031-682-961
SD/MU:	SD100592
WO:	

CIVIC ADDRESS: 3098 LINKS DR


LEGAL DESCRIPTION: LOT 15 DISTRICT LOT 4041 PLAN EPP114714

SERVICE TYPE	DIAMETER (mm)	MATERIAL	INVERT ELEV AT MAIN (m)	INVERT ELEV AT PROPERTY LINE (m)	INVERT ELEV AT SERVICE END (m)	COVER AT PROPERTY LINE (m)	DISTANCE INTO PROPERTY (m)	INSTALLATION DATE
SANITARY	100	PVC	654.71	655.30	655.37	2.59	3.00	JULY 2021
WATER	19	COPPER	654.88	655.30	655.40	2.69	3.00	JULY 2021
STORM	100	PVC	654.81	655.32	655.39	2.58	3.00	JULY 2021

ELECTRICAL / COMMUNICATIONS / GAS			
TYPE	PROVIDER	SIZE AND MATERIAL	LOCATION (UNDERGROUND/ OVERHEAD)
ELECTRICAL	BC HYDRO	75mm DB2	UNDERGROUND
COMMUNICATION	TELUS	50mm DB2	UNDERGROUND
COMMUNICATION	SHAW	50mm DB2	UNDERGROUND
GAS	FORTISBC	42 PROP/P.E.	UNDERGROUND

INFORMATION SHEETS: L&M ENGINEERING LIMITED PROJECT NUMBER 1253-06	SURVEY DATE: JULY 2021
INSTALLED BY: ABERDEEN GLEN DEVELOPMENT	
COMMENTS:	

THE INFORMATION CONTAINED HEREIN IS FOR INTERNAL USE ONLY.
NOT TO BE RELIED UPON UNLESS CONFIRMED BY SITE INVESTIGATION.

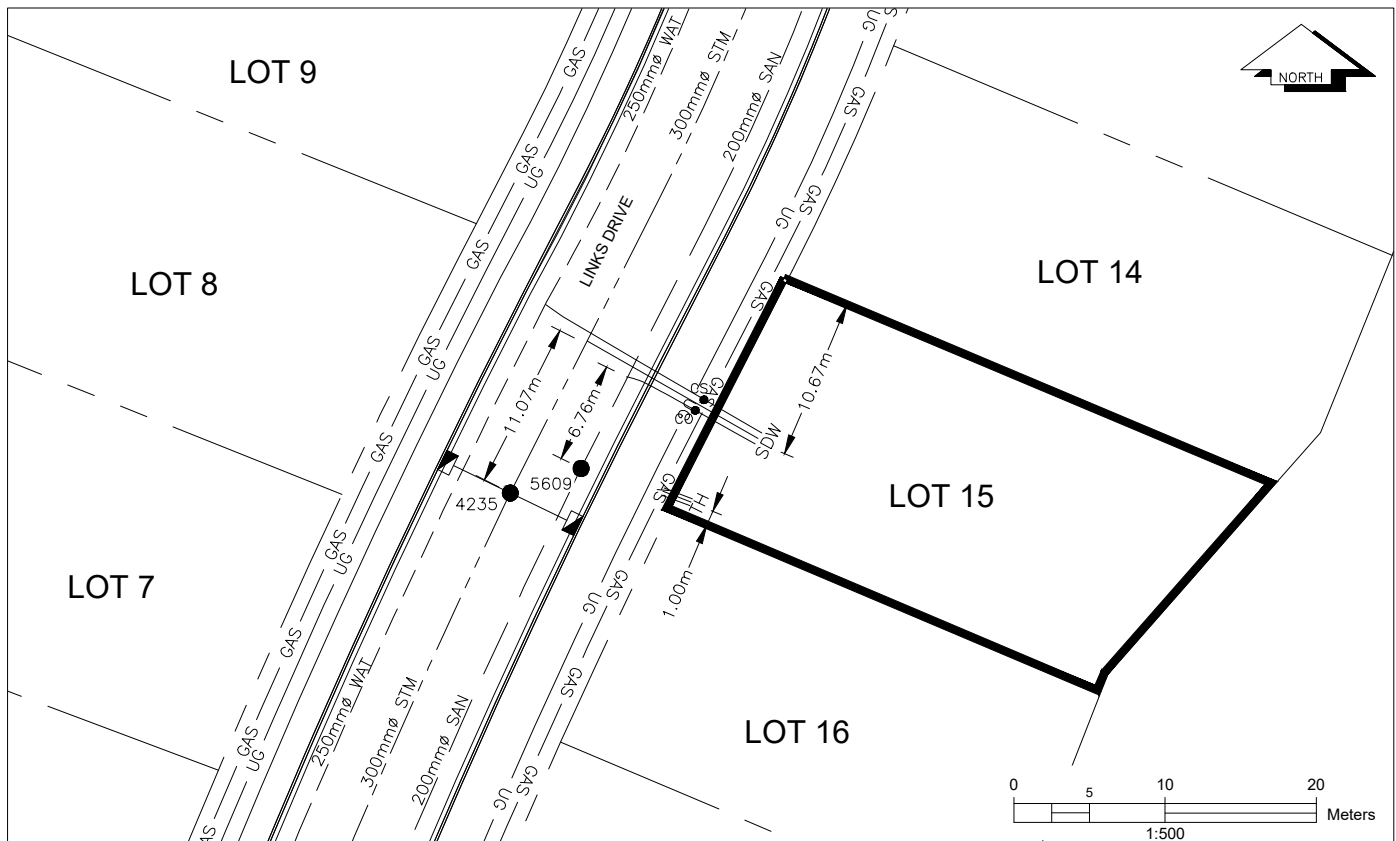

LEGEND:			
CS ● CURB STOP	— W — WATER SERVICE	— H — HYDRO SERVICE	— GAS — GAS
CO ● CLEAN OUT	— S — STORM SERVICE	— C — COMMUNICATION SERVICES	— UG — SHALLOW UTILITIES
	— SAN — SANITARY SERVICE		