



Legal Description: Lot: PCL E (CA9959331) Block: 180 District Lot: 343 Plan: 1268

| Service Type | Diameter (mm) | Material | Invert Elev @ Main (m) | Invert Elev @ Property Line (m) | | Invert Elev Service End | - | nce into erty (m) | Installation Date |
|--|---|----------|---------------------------|------------------------------------|--|----------------------------|------------|----------------------|----------------------|
| Sanitary | Unknown | Unknown | - | - | | - | | - | Unknown |
| Water | 19 | COPPER | - | - | | - | | - | Unknown |
| Storm | N/A | - | - | - | | - | | - | - |
| Sanit | Storm Service Connection Location Notes | | | | | | | | |
| Distance from downstream SAN MH #: Unknown | | | | | Distance from downstream STM MH #: N/A | | | | |
| Distance to upstream SAN MH #: Unknown | | | | | Distance to upstream STM MH #: N/A | | | | |
| | | | Mis | cellane | ous Utilities | | | | |
| Р | ower | С | Communications | | Cable | | | Gas | |
| BC Hydro | | | TELUS | | Shaw Cable | | | FortisBC | |
| Overhe | ad Service | С | Overhead Service | | Overhead Service | | | Underground Service | |
| Installation By: | Unknown | | | | | Draft Date: | 2022-10-05 | Survey Da | te: - |
| Comments: | | | | | | | | | |
| Water Service is ~7.0m North West from the North East corner of PCL E. | | | | | | | | | |
| | | | | | | | | | |

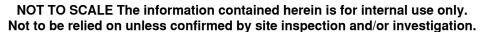

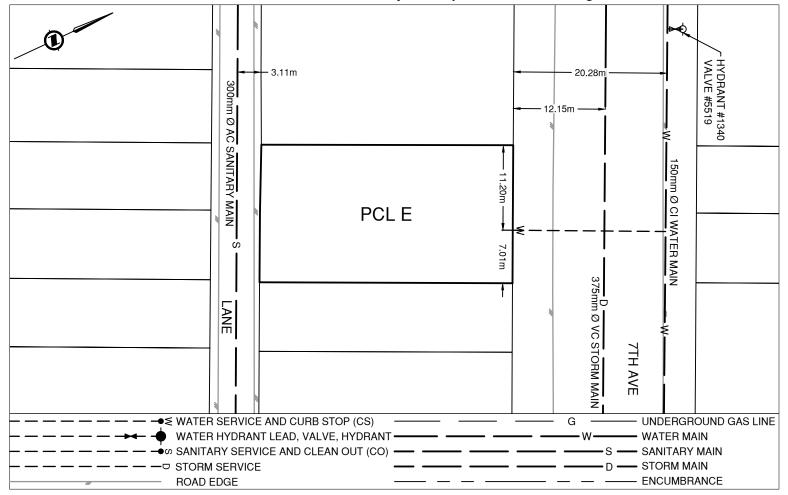

PID: 031701132