



CITY OF  
PRINCE GEORGE

Civic Address: 2516 LAURIER CRES

Legal Description: Lot: PCL A (CB158337) Block: 92 District Lot: 343 Plan: 1268

Lot Services Sketch

PID: 031768831

Service Type	Diameter (mm)	Material	Invert Elev @ Main (m)	Invert Elev @ Property Line (m)	Invert Elev @ Service End (m)	Distance into Property (m)	Installation Date
Sanitary	100	PVC	-	-	-	-	January 1975
Water	19	COPPER	-	-	-	-	Unknown
Storm	N/A	-	-	-	-	-	-


Sanitary Service Connection Location Notes	Storm Service Connection Location Notes
Distance from downstream SAN MH #2835: 61.98m	Distance from downstream STM MH #: N/A
Distance to upstream SAN MH #3083: 43.31m	Distance to upstream STM MH #: N/A

Miscellaneous Utilities			
Power	Communications	Cable	Gas
BC Hydro	TELUS	Shaw Cable	FortisBC
Overhead Service	Overhead Service	Overhead Service	Underground Service

Installation By:	Unknown	Draft Date:	2022-10-05	Survey Date:	-
------------------	---------	-------------	------------	--------------	---

Comments:
Water Service is ~4.9m South East from the North Corner of PCL A. Sanitary Service is ~7.0m North from the South West corner of PCL A.

**NOT TO SCALE** The information contained herein is for internal use only.  
Not to be relied on unless confirmed by site inspection and/or investigation.

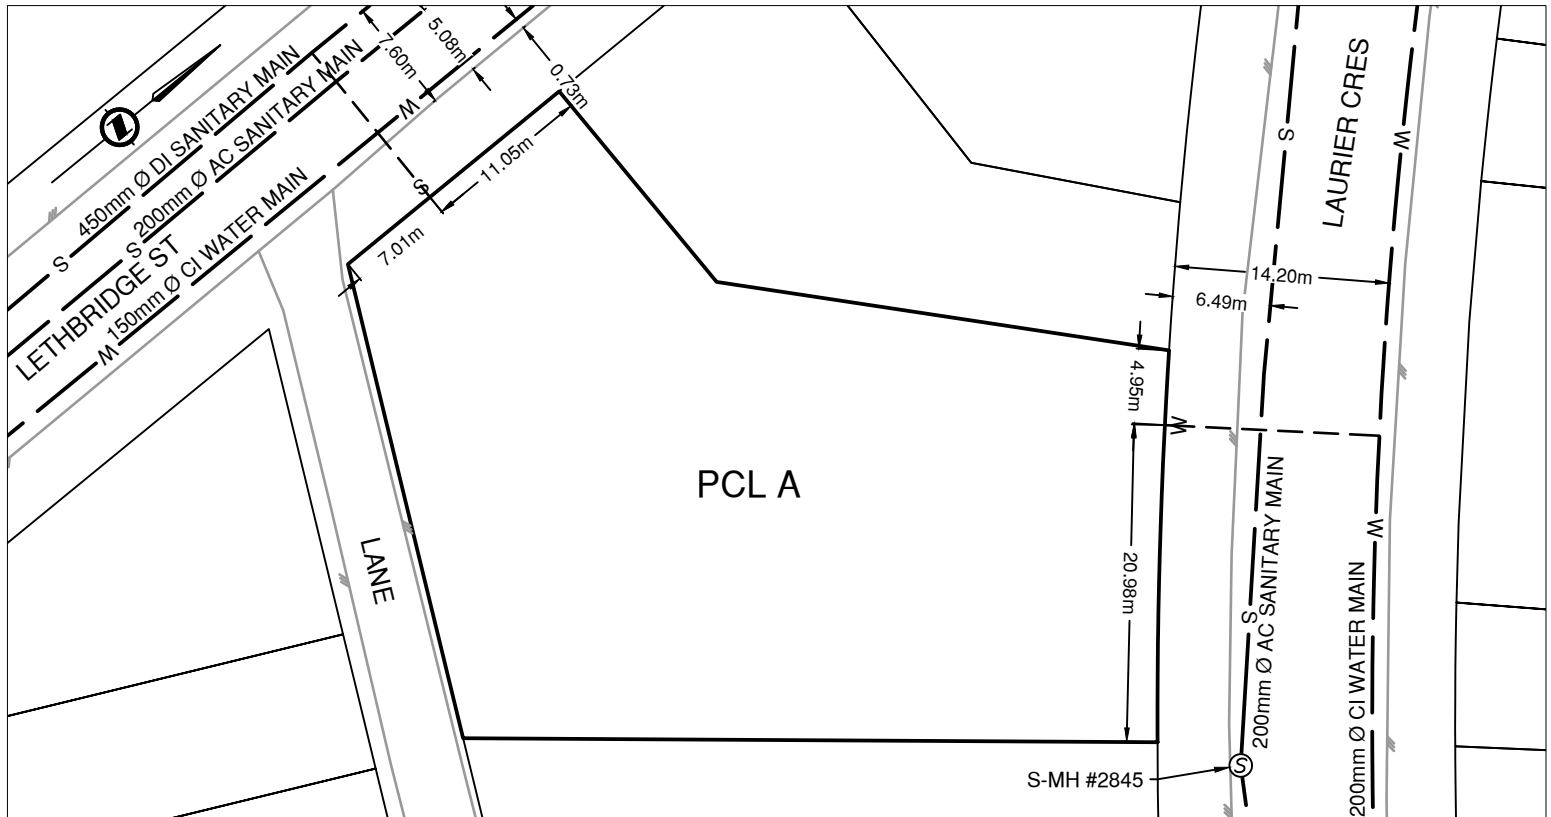

—●— WATER SERVICE AND CURB STOP (CS)	— G — UNDERGROUND GAS LINE
—●— WATER HYDRANT LEAD, VALVE, HYDRANT	— W — WATER MAIN
—●— SANITARY SERVICE AND CLEAN OUT (CO)	— S — SANITARY MAIN
—□— STORM SERVICE	— D — STORM MAIN
— ROAD EDGE	— ENCUMBRANCE