



City of Prince George History Sheet

PID:	031780512
SD/MU:	
WO:	

Civic Address: 1453 Garvin Street
1456 Liard Drive
3710 15th Ave

Legal Description: Lot: A District Lot: 936 Plan: EPP121464


Service Type	Diameter (mm)	Material	Invert Elev at main (m)	Invert Elev at property line (m)	Invert Depth at service end (m)	Distance into property (m)	Installation Date
Sanitary (west)	100mm	AC	-	604.04	1.83	-	April 1966
Sanitary (east)	100mm	AC	-	600.80	1.84	-	April 1966
Sanitary (south)	100mm	AC	-	601.97	2.06	-	April 1966
Water (east)	40mm	Copper	-	-	-	-	January 1965
Water (west)	40mm	Copper	-	-	-	-	January 1965
Water (south)	40mm	Copper	-	-	-	-	January 1964
Storm	N/A	N/A	-	-	-	-	

Service Connection Location				Sanitary (m)	Storm (m)
Distance from downstream San MH	829	towards upstream San MH	710	61.59	
Distance from downstream San MH	829	towards upstream San MH	707	50.79	-
Distance from downstream San MH	829	towards upstream San MH	830	78.53	-
Distance from downstream Stm MH	-	towards upstream Stm MH	-	-	-

Power	Size	Communications	Size	Cable	Size	Gas	Size
BC Hydro	-	Telus	-	Shaw	-	FortisBC	-
Overhead Service		Overhead Service		Overhead Service			

Installed by:	Survey Date:	-
Comments:		

NOT TO SCALE The information contained herein is for internal use only.
Not to be relied on unless confirmed by site inspection and/or investigation.

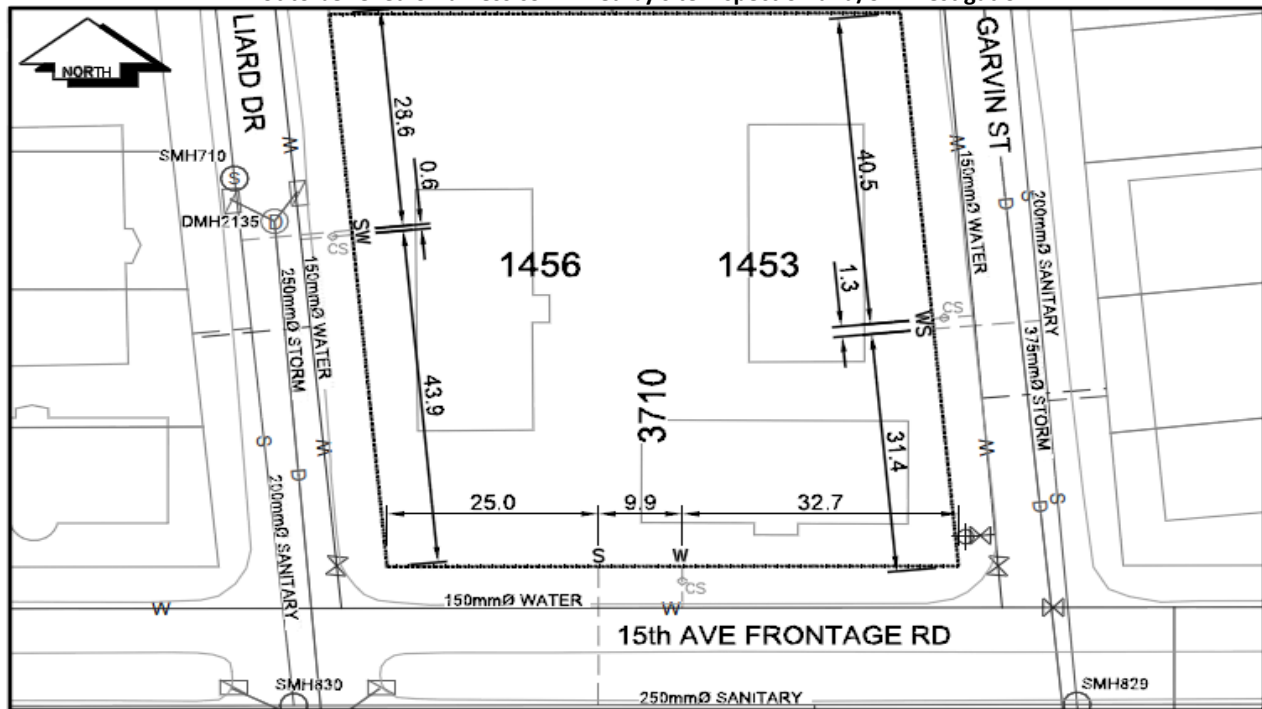

<p>LEGEND:</p> <p>CS CURB STOP</p> <p>CO CLEAN OUT</p> <p>W WATER VALVE</p>	<p>--- W WATER SERVICE</p> <p>--- S SANITARY SERVICE</p> <p>--- G GAS</p> <p>--- ENCUMBERANCE</p>	<p>--- D STORM SERVICE</p>
---	---	----------------------------

NOT TO SCALE