



CITY OF
PRINCE GEORGE

Civic Address: 2899 EVASKO RD

Legal Description: Lot: 2 District Lot: 634 Plan: EPP118953 Encumbrance: A1755

Lot Services Sketch

PID:

031791352


Service Type	Diameter (mm)	Material	Invert Elev @ Main (m)	Invert Elev @ Property Line (m)	Invert Elev @ Service End (m)	Distance into Property (m)	Installation Date
Sanitary	N/A	-	-	-	-	-	-
Water	19	COPPER	-	-	-	-	January 1970
Storm	N/A	-	-	-	-	-	-

Sanitary Service Connection Location Notes	Storm Service Connection Location Notes
Distance from downstream SAN MH #: N/A	Distance from downstream STM MH #: N/A
Distance to upstream SAN MH #: N/A	Distance to upstream STM MH #: N/A

Miscellaneous Utilities			
Power	Communications	Cable	Gas
BC Hydro	TELUS	Shaw Cable	FortisBC
Overhead Service	Overhead Service	Overhead Service	Underground Service

Installation By:	Unknown	Draft Date:	2022-12-19	Survey Date:	-
Comments:					
Water Service is ~13.6m North from the Southeast corner of Lot 2.					
See Page 2 for full size parcel sketch.					

NOT TO SCALE The information contained herein is for internal use only.
Not to be relied on unless confirmed by site inspection and/or investigation.

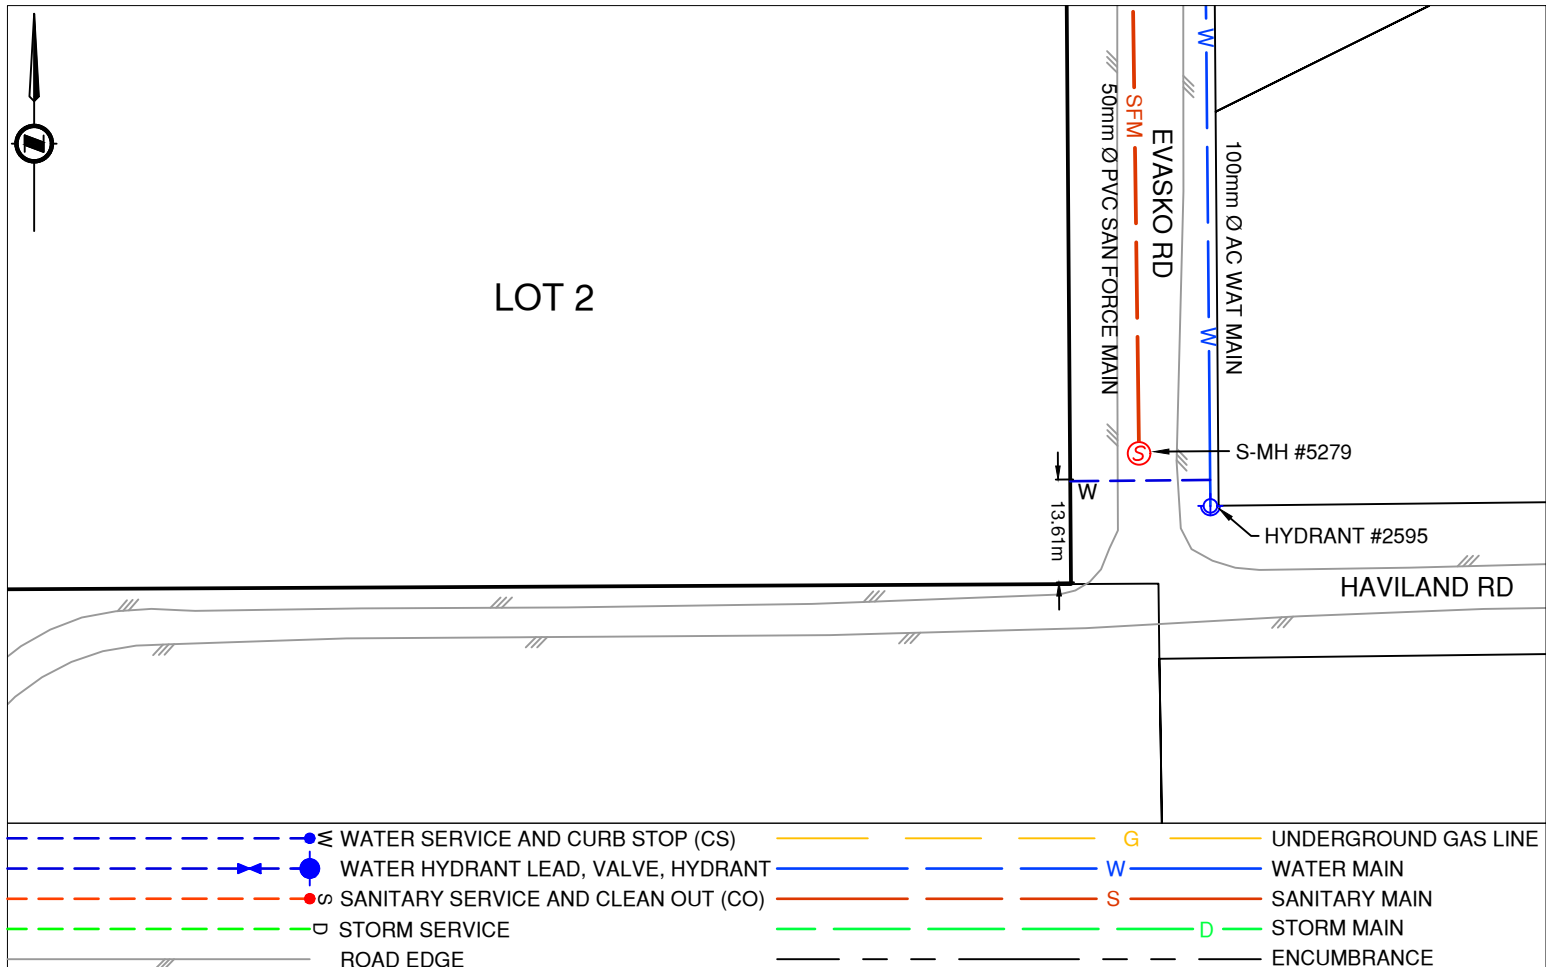



CITY OF
PRINCE GEORGE

Lot Services Sketch

NOT TO SCALE The information contained herein is for internal use only.
Not to be relied on unless confirmed by site inspection and/or investigation.

