



CITY OF
PRINCE GEORGE

City of Prince George HISTORY SHEET

PID:	031-811-949
SD/MU:	SD100658
WO:	

CIVIC ADDRESS: 5210 BREANNA AVE


LEGAL DESCRIPTION: LOT 17 DISTRICT LOT 2425 PLAN EPP122550

SERVICE TYPE	DIAMETER (mm)	MATERIAL	INVERT ELEV AT MAIN (m)	INVERT ELEV AT PROPERTY LINE (m)	INVERT ELEV AT SERVICE END (m)	COVER AT PROPERTY LINE (m)	DISTANCE INTO PROPERTY (m)	INSTALLATION DATE
SANITARY	100	PVC	761.83	762.08	762.14	2.35	3.00	AUG 2021
WATER	19	COPPER	760.96	762.07	762.13	2.44	3.00	AUG 2021
STORM	100	PVC	761.80	762.08	762.14	2.35	3.00	AUG 2021

ELECTRICAL / COMMUNICATIONS / GAS			
TYPE	PROVIDER	SIZE AND MATERIAL	LOCATION (UNDERGROUND/ OVERHEAD)
ELECTRICAL	BC HYDRO	75mm DB2	UNDERGROUND
COMMUNICATION	TELUS	50mm DB2	UNDERGROUND
COMMUNICATION	SHAW	50mm DB2	UNDERGROUND
GAS	FORTISBC	42 PROP/P.E.	UNDERGROUND

INFORMATION SHEETS: L&M ENGINEERING LIMITED PROJECT NUMBER 1631-06	SURVEY DATE: AUGUST 2021
INSTALLED BY: DATOFF BROS CONSTRUCTION LTD.	
COMMENTS:	

THE INFORMATION CONTAINED HEREIN IS FOR INTERNAL USE ONLY.
NOT TO BE RELIED UPON UNLESS CONFIRMED BY SITE INVESTIGATION.

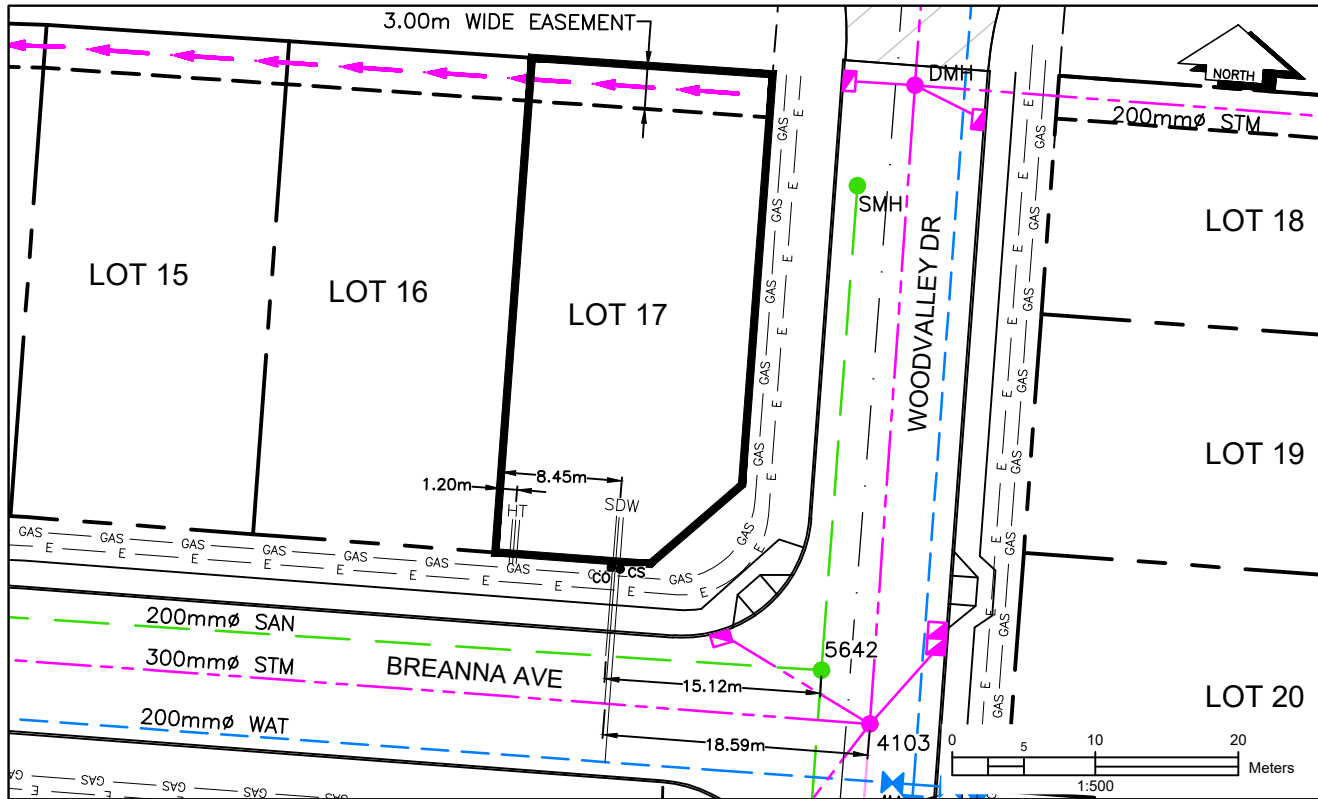

LEGEND:	CS ● CURB STOP	—D— WATER SERVICE	—H— HYDRO SERVICE	—GAS— GAS
CO ● CLEAN OUT	—S— STORM SERVICE	—T— TELECOMMUNICATIONS	—UG— GAS SHALLOW UTILITIES	
	—W— SANITARY SERVICE			