

SD/MU:	SD100658
WO:	

ADDRESS: 5108 WOODVALLEY DR

DESCRIPTION: LOT 22 DISTRICT LOT 2425 PLAN EPP122550

PIPE	DIAMETER (mm)	MATERIAL	INVERT ELEV AT MAIN (m)	INVERT ELEV AT PROPERTY LINE (m)	INVERT ELEV AT SERVICE END (m)	COVER AT PROPERTY LINE (m)	DISTANCE INTO PROPERTY (m)	INSTALLATION DATE
WATER	100	PVC	762.54	762.80	762.93	2.00	3.00	JULY 2021
SEWER	19	COPPER	762.00	762.58	762.64	2.30	3.00	JULY 2021
STORM	100	PVC	762.54	762.74	762.80	2.06	3.00	JULY 2021

ELECTRICAL / COMMUNICATIONS / GAS

TYPE	PROVIDER	SIZE AND MATERIAL	LOCATION (UNDERGROUND/ OVERHEAD)
ELECTRICAL	BC HYDRO	75mm DB2	UNDERGROUND
COMMUNICATIONS	TELUS	50mm DB2	UNDERGROUND
COMMUNICATIONS	SHAW	50mm DB2	UNDERGROUND
COMMUNICATIONS	FORTISBC	42 PROP/P.E.	UNDERGROUND


FORMER SHEETS: L&M ENGINEERING LIMITED PROJECT NUMBER 1631-06

SURVEY DATE: JULY 2021

APPROVED BY: DATOFF BROS CONSTRUCTION LTD.

REMARKS:

THE INFORMATION CONTAINED HEREIN IS FOR INTERNAL USE ONLY.
NOT TO BE RELIED UPON UNLESS CONFIRMED BY SITE INVESTIGATION.

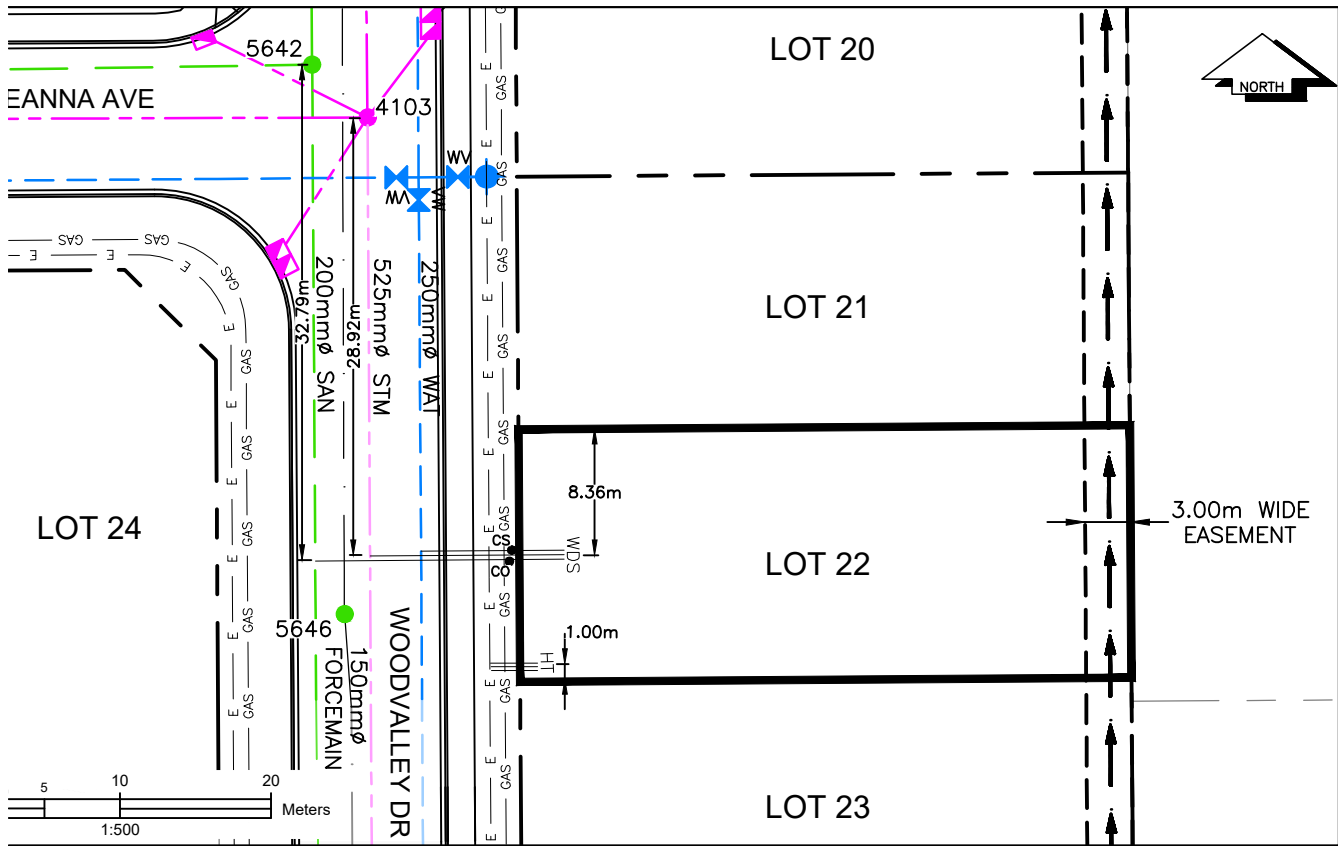

ND:	CS CURB STOP	W WATER SERVICE	—H— HYDRO SERVICE	—GAS— GAS
	CO CLEAN OUT	S D W STORM SERVICE	—T— TELECOMMUNICATIONS	—UG— GAS SHALLOW UTILITIES
		S SANITARY SERVICE		