



CITY OF  
PRINCE GEORGE

# City of Prince George HISTORY SHEET

|        |             |
|--------|-------------|
| PID:   | 031-812-023 |
| SD/MU: | SD100658    |
| WO:    |             |

CIVIC ADDRESS: 5223 BREANNA AVE


LEGAL DESCRIPTION: LOT 25 DISTRICT LOT 2524 PLAN EPP122550

| SERVICE TYPE | DIAMETER (mm) | MATERIAL | INVERT ELEV AT MAIN (m) | INVERT ELEV AT PROPERTY LINE (m) | INVERT ELEV AT SERVICE END (m) | COVER AT PROPERTY LINE (m) | DISTANCE INTO PROPERTY (m) | INSTALLATION DATE |
|--------------|---------------|----------|-------------------------|----------------------------------|--------------------------------|----------------------------|----------------------------|-------------------|
| SANITARY     | 100           | PVC      | 761.98                  | 762.20                           | 762.45                         | 2.33                       | 3.00                       | AUG 2021          |
| WATER        | 19            | COPPER   | 761.15                  | 762.15                           | 762.22                         | 2.46                       | 3.00                       | AUG 2021          |
| STORM        | 100           | PVC      | 762.08                  | 762.20                           | 762.26                         | 2.33                       | 3.00                       | AUG 2021          |

| ELECTRICAL / COMMUNICATIONS / GAS |          |                   |                                   |
|-----------------------------------|----------|-------------------|-----------------------------------|
| TYPE                              | PROVIDER | SIZE AND MATERIAL | LOCATION ( UNDERGROUND/ OVERHEAD) |
| ELECTRICAL                        | BC HYDRO | 75mm DB2          | UNDERGROUND                       |
| COMMUNICATION                     | TELUS    | 50mm DB2          | UNDERGROUND                       |
| COMMUNICATION                     | SHAW     | 50mm DB2          | UNDERGROUND                       |
| GAS                               | FORTISBC | 42 PROP/P.E.      | UNDERGROUND                       |

|  |                       |
|--|-----------------------|
| INFORMATION SHEETS: L&M ENGINEERING LIMITED PROJECT NUMBER 1631-06 | SURVEY DATE: AUG 2021 |
| INSTALLED BY: DATOFF BROS CONSTRUCTION LTD.                        |                       |
| COMMENTS:  |                       |

THE INFORMATION CONTAINED HEREIN IS FOR INTERNAL USE ONLY.  
NOT TO BE RELIED UPON UNLESS CONFIRMED BY SITE INVESTIGATION.

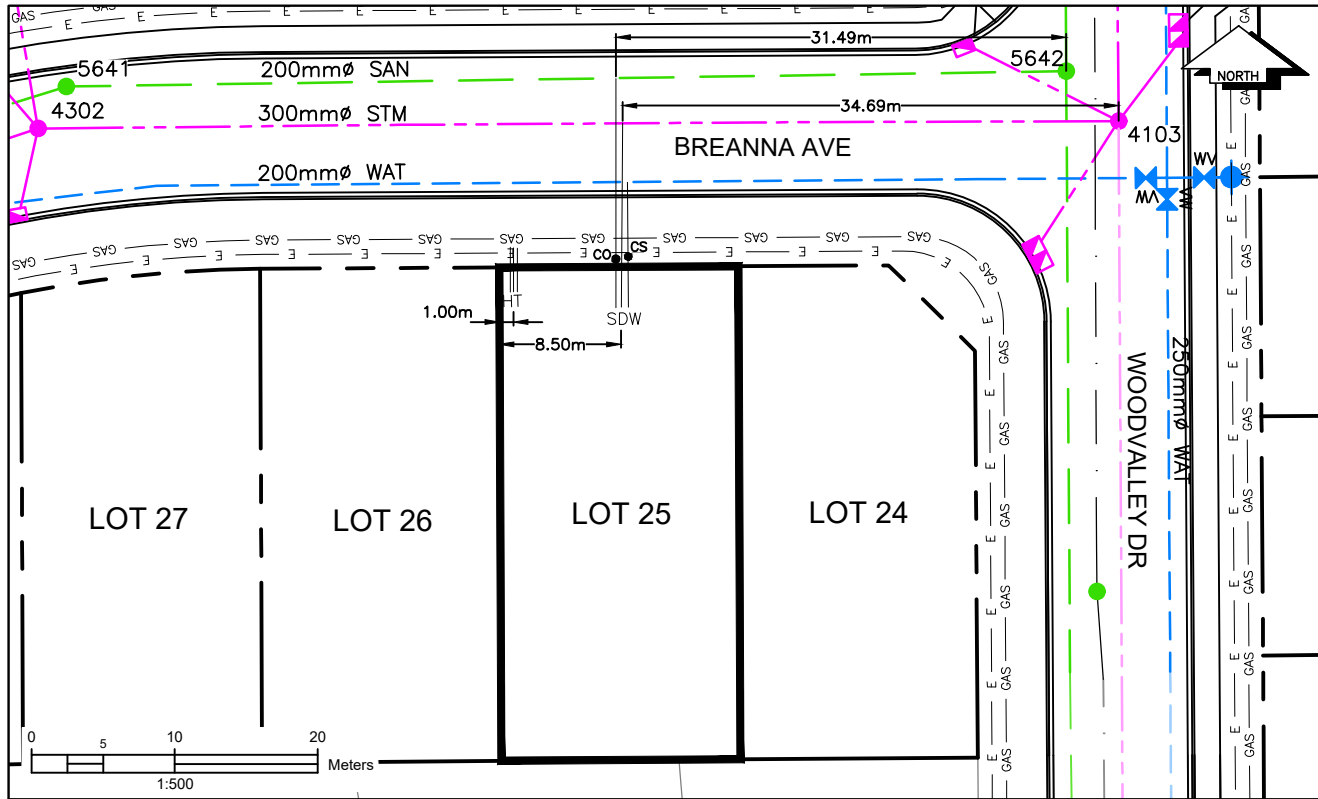

**LEGEND:**

|                |                          |                          |                          |
|----------------|--------------------------|--------------------------|--------------------------|
| CS ● CURB STOP | — D — WATER SERVICE      | — I — HYDRO SERVICE      | — GAS — GAS              |
| CO ● CLEAN OUT | — S — STORM SERVICE      | — T — TELECOMMUNICATIONS | — UG — SHALLOW UTILITIES |
|                | — 100 — SANITARY SERVICE |                          |                          |