


Civic Address: 1838 INGLEDEW ST

Legal Description: Lot: PCL F (CB318240) Block: 305 District Lot: 343 Plan: 1268

Service Type	Diameter (mm)	Material	Invert Elev @ Main (m)		rt Elev @ rty Line (m)	Invert Elev Service End	-	ance into perty (m)	Installation Date	
Sanitary	Unknown	Unknown	-					-	Unknown	
Water	19	COPPER	-	-		-		-	January 1956	
Storm	N/A	-	-	-		-		-	-	
Sanitary Service Connection Location Notes Storm Service Connection Location Not						Notes				
Distance from downstream SAN MH #: Unknown					Distance from downstream STM MH #: N/A					
Distance to upstream SAN MH #: Unknown					Distance to upstream STM MH #: N/A					
			Mis	cellane	ous Utilities					
Power		Communications		Cable			Gas			
BC Hydro			TELUS		Shaw Cable			FortisBC		
Overhea	ad Service	(Overhead Service		Overhead Service			Underground Service		
Installation By:	Unknown					Draft Date:	2022-12-2	2 Survey D	ate: -	
				Comr	nents:		1	I	I	
	1 9m South from th	Northwest cor	ner of PCL F. No lo	cation av	ailable for Sanita	ry Service				

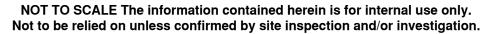

STM MAIN	- D-MH #1038	LANE		
	ND CURB STOP (CS)	W	/ D	UNDERGROUND GAS LINE WATER MAIN SANITARY MAIN STORM MAIN ENCUMBRANCE