Invert Elev

@ Main (m)

739.72

739.30



Service Type

Sanitary

Water

Storm

Civic Address: 6991 IRENE RD

Legal Description: Lot: E District Lot: 1599 Plan: EPP124546 Diameter

(mm)

100

19

N/A

Distance from downstream SAN MH #4296: 34.40m

Material

PVC

COPPER

Installation

Date

October 2022

October 2022

Distance into

Property (m)

2.14

2.37

-

Invert Elev @

Service End (m)

740.15

740.13

Sanitary Service Connection Location Notes Storm Service Connection Location Notes Distance from downstream STM MH #: N/A Distance to upstream STM MH #: N/A


Invert Elev @

Property Line (m)

740.04

740.09

_

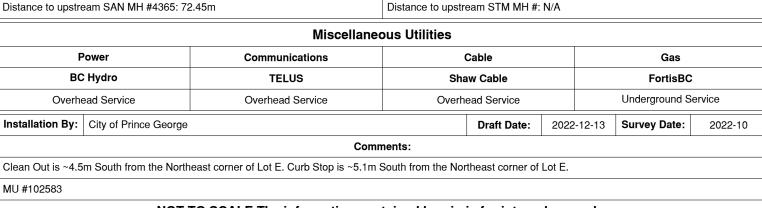

NOT TO SCALE The information contained herein is for internal use only. Not to be relied on unless confirmed by site inspection and/or investigation.

