Lot Services Sketch



PID: 031862004

Civic Address: 6303 GISCOME RD

Legal Description: Lot: 1 Plan: EPP117134 Encumbrance: BCP364

Service Type	Diameter (mm)	Material	Invert Elev @ Main (m)	Invert Elev @ Property Line (m)	Invert Elev @ Service End (m)	Distance into Property (m)	Installation Date
Sanitary	100	PVC	-	-	-	-	August 2003
Water	25	COPPER	-	-	-	-	August 2003
Storm	N/A	-	-	-	-	-	-

Sanitary Service Connection Location Notes	Storm Service Connection Location Notes		
Distance from downstream SAN MH #1140: 0.00m	Distance from downstream STM MH #: N/A		
Distance to upstream SAN MH #1140: 0.00m	Distance to upstream STM MH #: N/A		

Power Communications Cable Gas BC Hydro TELUS Shaw Cable FortisBC Overhead Service Overhead Service Overhead Service Underground Service	Miscellaneous Utilities							
, , , , , , , , , , , , , , , , , , , ,	Power	Communications	Cable	Gas				
Overhead Service Overhead Service Overhead Service Underground Service	BC Hydro	TELUS	Shaw Cable	FortisBC				
	Overhead Service	Overhead Service	Overhead Service	Underground Service				


Installation By:City of Prince GeorgeDraft Date:2023-03-13Survey Date:August 2003

Comments:

Sanitary Service is ~24.0m West from the Northeast corner of Lot 1. Water Service is ~26.5m West from the Northeast corner of Lot 1.

NOT TO SCALE The information contained herein is for internal use only. Not to be relied on unless confirmed by site inspection and/or investigation.

SEE PAGE 2 FOR SKETCH.

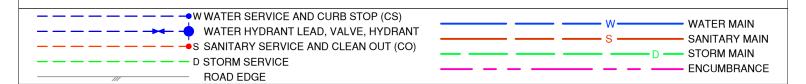



NOT TO SCALE The information contained herein is for internal use only. Not to be relied on unless confirmed by site inspection and/or investigation.

