



CITY OF PRINCE GEORGE

Civic Address: ~~540 EWERT ST~~Legal Description: ~~Lot: 17 Block: 32 District Lot: 937 Plan: 752~~ Parcel D Block 32 District Lot 937 Plan 752 (CB552408)

Lot Services Sketch

Page 1 of 2

PID:

~~007892047~~

Service Type	Diameter (mm)	Material	Invert Elev @ Main (m)	Invert Elev @ Property Line (m)	Invert Elev @ Service End (m)	Distance into Property (m)	Installation Date
Sanitary	N/A	-	-	-	-	-	-
Water	N/A	-	-	-	-	-	-
Storm	N/A	-	-	-	-	-	-

Sanitary Service Connection Location Notes	Storm Service Connection Location Notes
Distance from downstream SAN MH #: N/A	Distance from downstream STM MH #: N/A
Distance to upstream SAN MH #: N/A	Distance to upstream STM MH #: N/A


Miscellaneous Utilities			
Power	Communications	Cable	Gas
BC Hydro	TELUS	Shaw Cable	FortisBC
Overhead Service	Overhead Service	Overhead Service	Underground Service

Installation By: -	Draft Date: 2022-12-21	Survey Date: -
--------------------	------------------------	----------------

Comments:

Lot 17 is not serviced.

NOT TO SCALE The information contained herein is for internal use only.
Not to be relied on unless confirmed by site inspection and/or investigation.

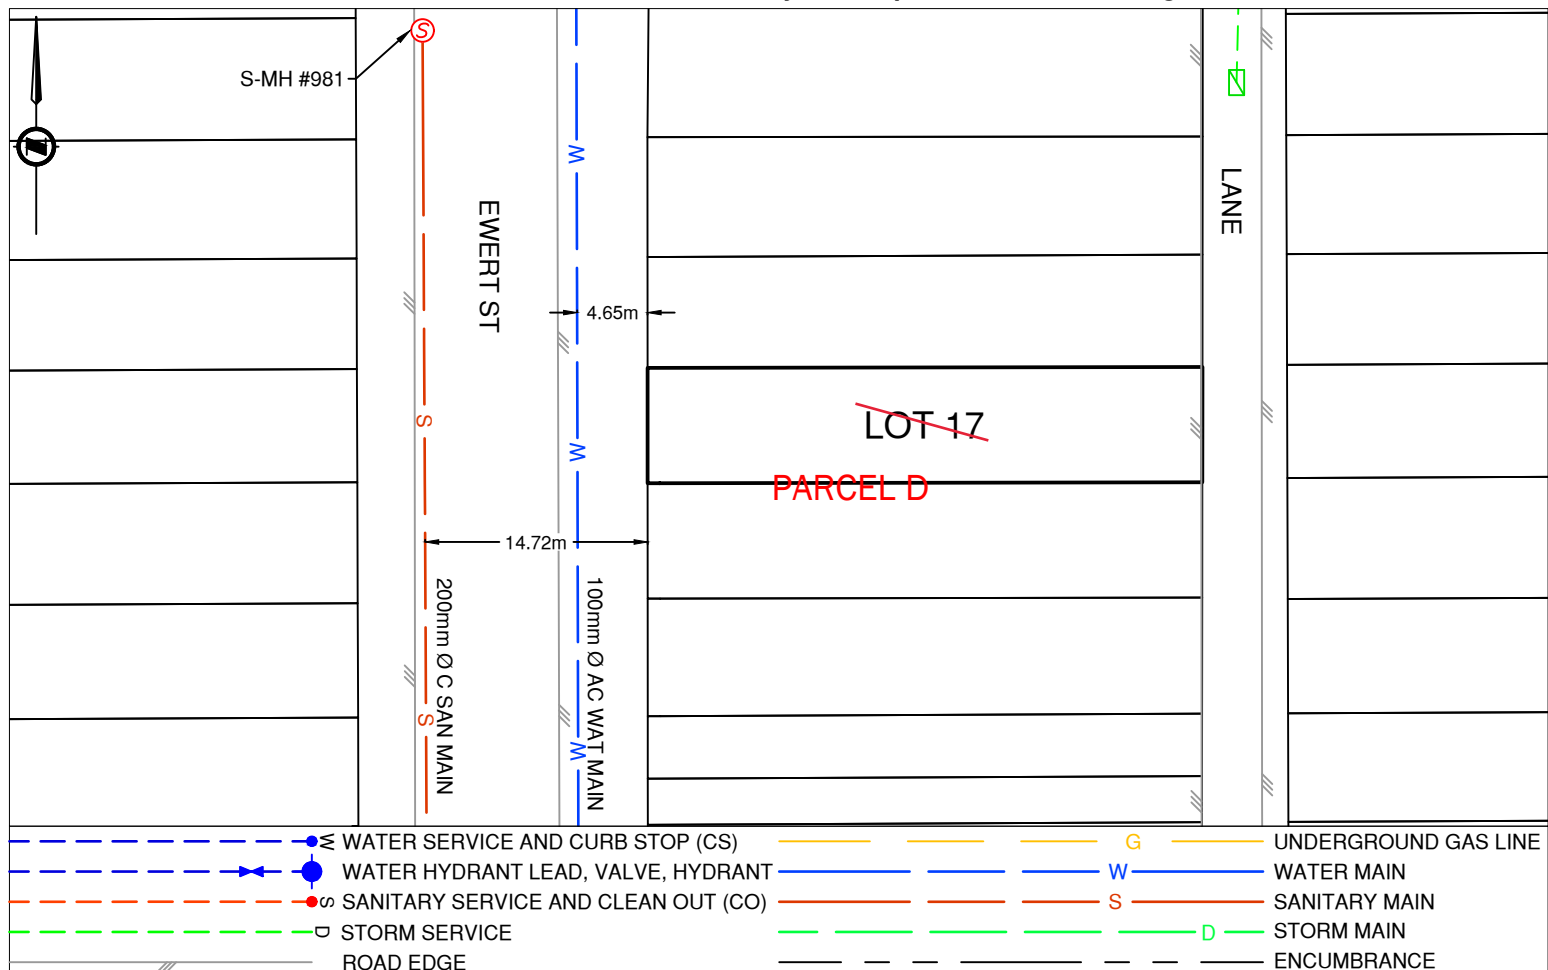



CITY OF PRINCE GEORGE

Civic Address: 548 EWERT ST

Legal Description: ~~Lot: 18 Block: 32 District Lot: 937 Plan: 752~~ Parcel D Block 32 District Lot 937 Plan 752 (CB552408)

Lot Services Sketch

Page 2 of 2

PID:

~~007891962~~

Service Type	Diameter (mm)	Material	Invert Elev @ Main (m)	Invert Elev @ Property Line (m)	Invert Elev @ Service End (m)	Distance into Property (m)	Installation Date
Sanitary	N/A	-	-	-	-	-	-
Water	N/A	-	-	-	-	-	-
Storm	N/A	-	-	-	-	-	-

Sanitary Service Connection Location Notes	Storm Service Connection Location Notes
Distance from downstream SAN MH #: N/A	Distance from downstream STM MH #: N/A
Distance to upstream SAN MH #: N/A	Distance to upstream STM MH #: N/A

Miscellaneous Utilities			
Power	Communications	Cable	Gas
BC Hydro	TELUS	Shaw Cable	FortisBC
Overhead Service	Overhead Service	Overhead Service	Underground Service

Installation By: -	Draft Date: 2022-12-21	Survey Date: -
--------------------	------------------------	----------------

Comments:

Lot 18 is not serviced.

NOT TO SCALE The information contained herein is for internal use only.
Not to be relied on unless confirmed by site inspection and/or investigation.

