



PID:	031-944-833
SD/MU:	SD100672
WO:	


LEGAL DESCRIPTION: LOT 2 DISTRICT LOT 748 PLAN EPP122554

SERVICE TYPE	DIAMETER (mm)	MATERIAL	INVERT ELEV AT MAIN (m)	INVERT ELEV AT PROPERTY LINE (m)	INVERT ELEV AT SERVICE END (m)	COVER AT PROPERTY LINE (m)	DISTANCE INTO PROPERTY (m)	INSTALLATION DATE
SANITARY	150	PVC	669.10	669.32	669.34	1.80	3.00	SEPT 2022
WATER	200	PVC	667.73	667.56	667.59	3.51	3.00	SEPT 2022
STORM	250	PVC	668.38	668.60	668.68	2.45	6.00	SEPT 2022

TYPE	PROVIDER	SIZE AND MATERIAL	LOCATION ( UNDERGROUND/ OVERHEAD)
ELECTRICAL	BC HYDRO	75mm DB2	UNDERGROUND
COMMUNICATION	TELUS	100mm DB2	UNDERGROUND
COMMUNICATION	SHAW	75mm DB2	UNDERGROUND

INFORMATION SHEETS: L&M ENGINEERING LIMITED PROJECT NUMBER 1615-07	SURVEY DATE: SEPT 2022
INSTALLED BY: MGN PROJECT MANAGEMENT INC/11300455 BC LTD	
COMMENTS:	

THE INFORMATION CONTAINED HEREIN IS FOR INTERNAL USE ONLY.  
NOT TO BE RELIED UPON UNLESS CONFIRMED BY SITE INVESTIGATION.

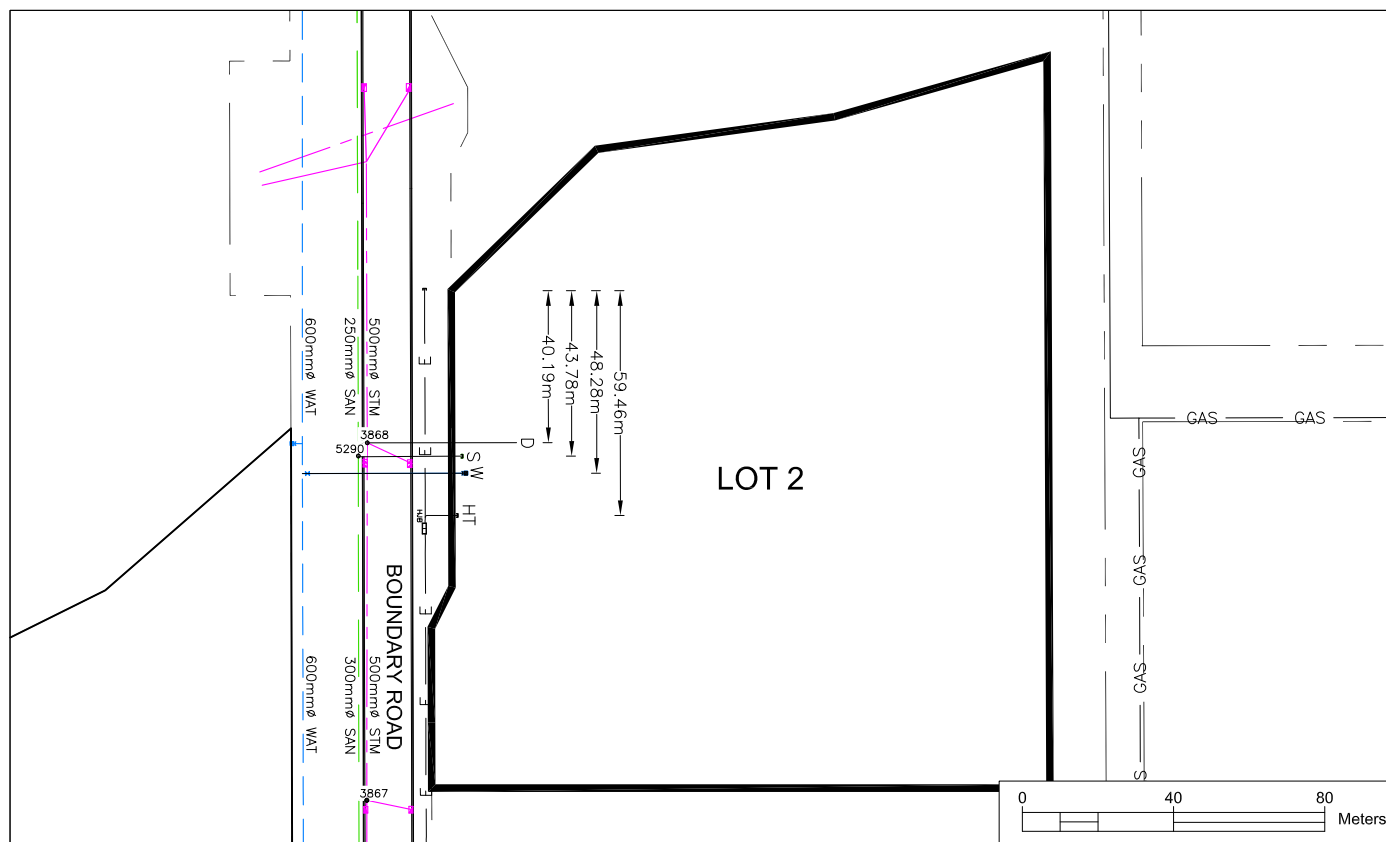

**LEGEND:**

CS ● CURB STOP	— W — WATER SERVICE	— H — HYDRO SERVICE	— GAS — GAS
CO ● CLEAN OUT	— S D W — STORM SERVICE	— T — TELECOMMUNICATIONS	— UG — SHALLOW UTILITIES
	— S — SANITARY SERVICE		