

City of Prince George

HISTORY SHEET

032-003-218

PID: ~~029-310-491~~

Scale: 1:500

EPP124390

Legal: ~~LOT 25~~ Lot 1

D.L.: 2003


PLAN: ~~EPP31288~~Address: **3668 PARKVIEW CRES**

Sanitary Connection:#	SIZE: 100mmØ	MATERIAL: PVC	INV. AT R 710.75m	CONNECTED
Water Connection:#	SIZE: 19mmØ	MATERIAL: Copper	INV. AT R 710.61m	
Storm Connection:#	SIZE: 100mmØ	MATERIAL: PVC	INV. AT R 710.75m	CONNECTED
Cash Receipt No's:	WATER	SANITARY	STORM	
CURB FROM PROPERTY LINE	5m		PAVEMENT WIDTH	10m
HYDRO	75mm DB2	U/G CONNECTION	✓	
TELEPHONE	100mm DB2	U/G CONNECTION	✓	
GAS	42 PROP/P.E.			

Information Sheets: REF. DWGS. L&M ENGINEERING LTD. JOB. 1273-17-04 DWGS.

Comments: CS CURB STOP SDW WATER SERVICE SDW HYDRO SERVICE
 CO CLEAN OUT SDW STORM SERVICE SDW CABLE SERVICE
 SDW SANITARY SERVICE SDW TELECOMMUNICATIONS GAS
 ELECTRICAL

THE INFORMATION CONTAINED HEREIN IS FOR INTERNAL USE ONLY.
 NOT TO BE RELIED UPON UNLESS CONFIRMED BY THE SITE INSPECTION AND/OR INVESTIGATION

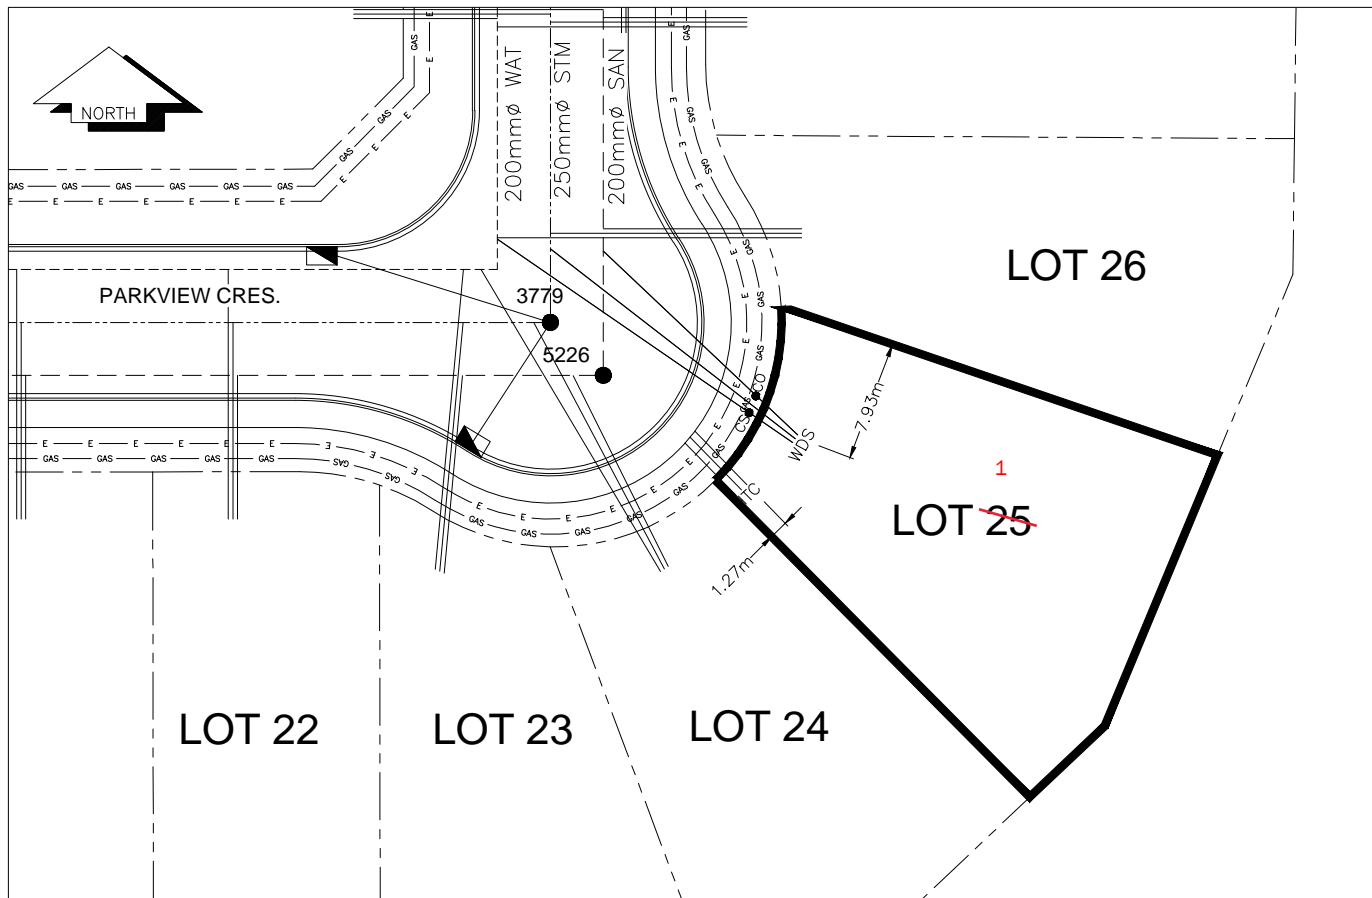

SANITARY, STORM & WATER SERVICE INVERTS	SANITARY	WATER	STORM
1. Distance from San. M.H. <u>5226</u> toward San. M.H. <u>5227</u> to lot service connection point is:	8.40m	N/A	N/A
1a.Distance from Stm. M.H. <u>3779</u> toward Stm. M.H. <u>3781</u> to lot service connection point is:	N/A	N/A	4.65m
2. Main Size at connection point is	200mmØ	200mmØ	250mmØ
3. Invert of service at main conn. stub point is	709.81m	708.60m	709.68m
4. Invert at service end is	710.93m	710.90m	710.93m
5. Cover at property line in meters	2.06m	2.28m	2.06m
6. Survey Date: MAY 2012 Book Ref.:1273-14-04 By:L&M ENGINEERING LTD			

SANITARY HISTORY:

DATE INSTALLED: JULY 2012

INSTALLED BY: SUNLAND UTILITIES LTD

WATER HISTORY:

DATE INSTALLED: JULY 2012

INSTALLED BY: SUNLAND UTILITIES LTD.

STORM HISTORY:

DATE INSTALLED: JULY 2012

INSTALLED BY: SUNLAND UTILITIES LTD.