


## PRINCE GEORGE Civic Address: 410 MOFFAT ST

Legal Description: Lot: PCL D (CB976729) Block: 50 District Lot: 937 Plan: 752

Service Type	Diameter (mm)	Material	Invert Elev @ Main (m)	Invert Elev @ Property Line (m)		Invert Elev @ Service End (m		rty (m)	stallation Date	
Sanitary	100	AC	-	-		-		-	Unknown	
Water	20	COPPER	-	-		-		-	JAN 1962	
Storm	N/A	-	-	-		-		-	-	
Sanitary Service Connection Location Notes					Storm Service Connection Location Notes					
Distance from downstream SAN MH #2589: Unknown					Distance from downstream STM MH #: N/A					
Distance to upstream SAN MH #958: Unknown					Distance to upstream STM MH #: N/A					
			Mis	scellane	ous Utilities					
Power		Communications			Cable			Gas		
BC Hydro		TELUS		Shaw Cable			FortisBC			
Overhead Service		C	Overhead Service		Overhead Service			Underground Service		
Installation By: Unknown						Draft Date:	FEB 2024	Survey Date:	JUL 2023	
Comments:										
Water Service is ~5.	1m South from th	e North West cor	mer of PCL D. San	itary Servi	ce location unkn	own.				

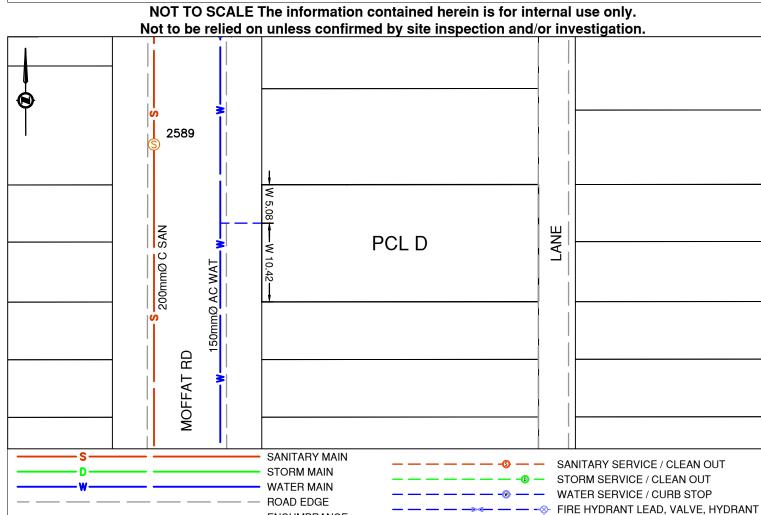

ENCUMBRANCE