



CITY OF
PRINCE GEORGE

Civic Address: 150 BRUNSWICK ST

Legal Description: Lot: A District Lot: 343 Plan: EPP132854

Lot Services Sketch

PID: 032102771

Service Type	Diameter (mm)	Material	Invert Elev @ Main (m)	Invert Elev @ Property Line (m)	Invert Elev @ Service End (m)	Distance into Property (m)	Installation Date
Sanitary	Unknown	Unknown	-	-	-	-	JAN 1959
Water (W1)	150	Galvanized	-	-	-	-	Unknown
Water (W2)	50	Copper	-	-	-	-	Unknown
Storm	N/A	-	-	-	-	-	-

Sanitary Service Connection Location Notes	Storm Service Connection Location Notes
Distance from downstream SAN MH #1871: 64.9m	Distance from downstream STM MH #: N/A
Distance to upstream SAN MH #2710: 11.9m	Distance to upstream STM MH #: N/A

Miscellaneous Utilities			
Power	Communications	Cable	Gas
BC Hydro	TELUS	Shaw Cable	FortisBC
Overhead Service	Overhead Service	Overhead Service	Underground Service

Installation By:	Unknown	Draft Date:	FEB 2024	Survey Date:	N/A
Comments:					
Water Service W1 is ~37.6m South from the North West corner of Lot A. Water Service W2 is ~39.8m South from the North West corner of Lot A.					
Sanitary Service is ~23.2m South from the North East corner of Lot A.					

**NOT TO SCALE The information contained herein is for internal use only.
Not to be relied on unless confirmed by site inspection and/or investigation.**

SEE PAGE 2 FOR SKETCH DETAILS

	SANITARY MAIN		SANITARY SERVICE / CLEAN OUT
	STORM MAIN		STORM SERVICE / CLEAN OUT
	WATER MAIN		WATER SERVICE / CURB STOP
	ROAD EDGE		FIRE HYDRANT LEAD, VALVE, HYDRANT
	ENCUMBRANCE		




Lot Services Sketch

PID: 032102771

CITY OF
PRINCE GEORGE

Civic Address: 150 BRUNSWICK ST

Legal Description: Lot: A District Lot: 343 Plan: EPP132854

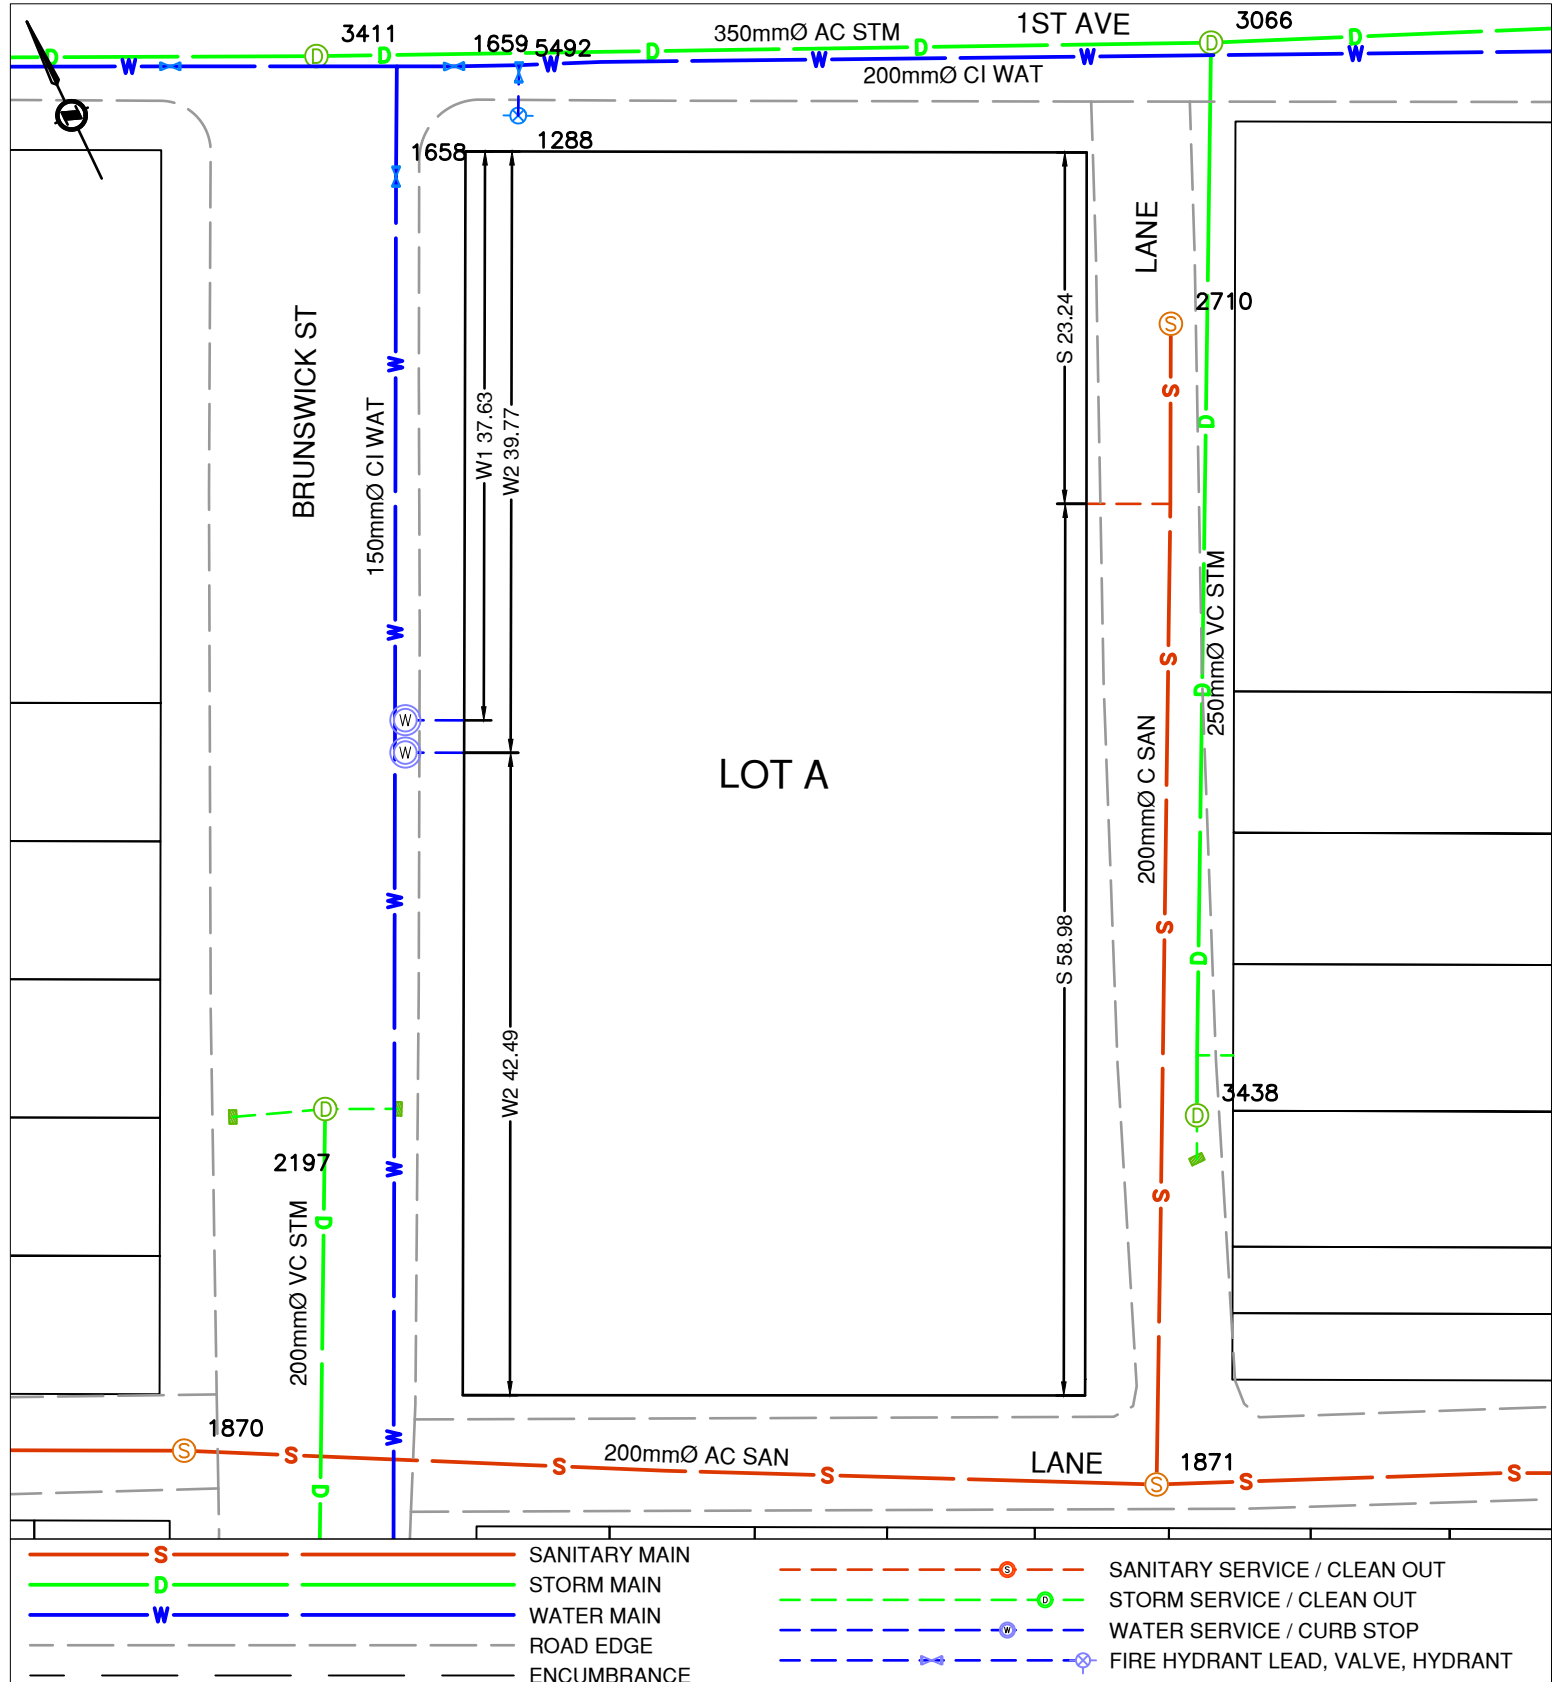

NOT TO SCALE The information contained herein is for internal use only.
Not to be relied on unless confirmed by site inspection and/or investigation.